
404


#1988

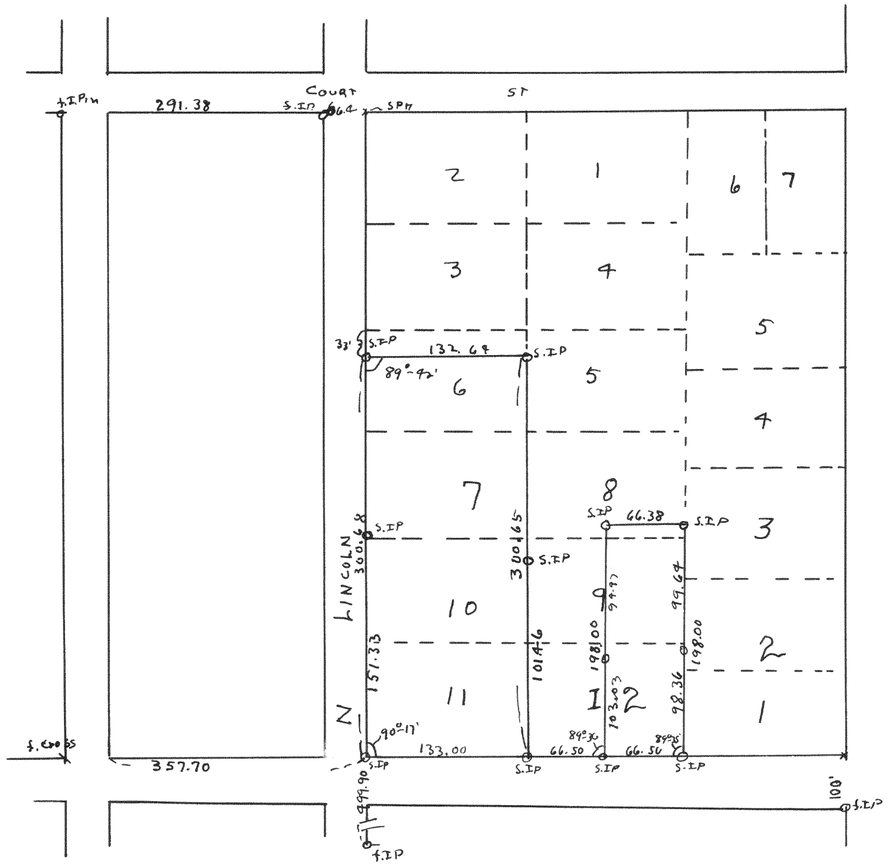

Plat of survey of lots 7, 10, 11, & part of lots 6, 8, 9 & 12 in Block 22
City of Elkhorn, Walworth County Wisconsin
July 15, 1998

Lloyd S Jensen
County Surveyor

#1989

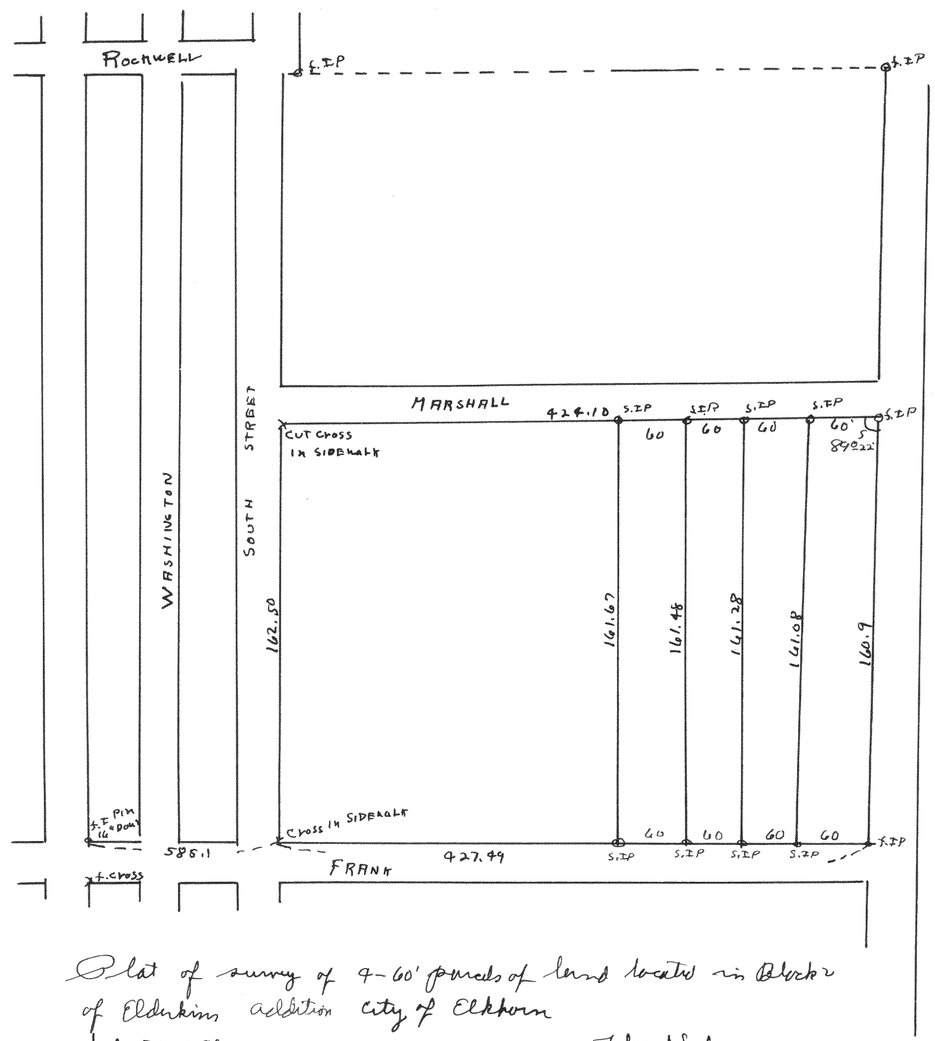

Plat of survey of 4-60' parcels of land located in Block 2
of Eldorkins addition City of Elkhorn
July 30, 1998

Lloyd S Jensen
County Surveyor