

1990

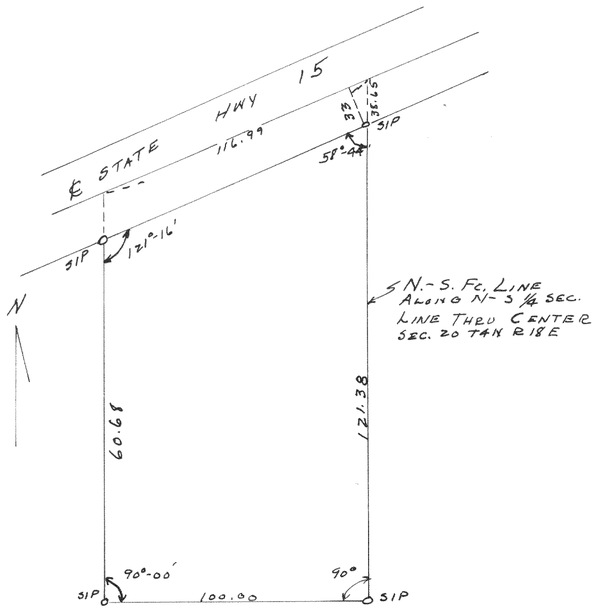

Plat of survey of a parcel of land located in the SW1/4 of Section 20, T4N R18E Walworth County.
April 1947 Floyd L. Jensen Cty. Surv.

1991

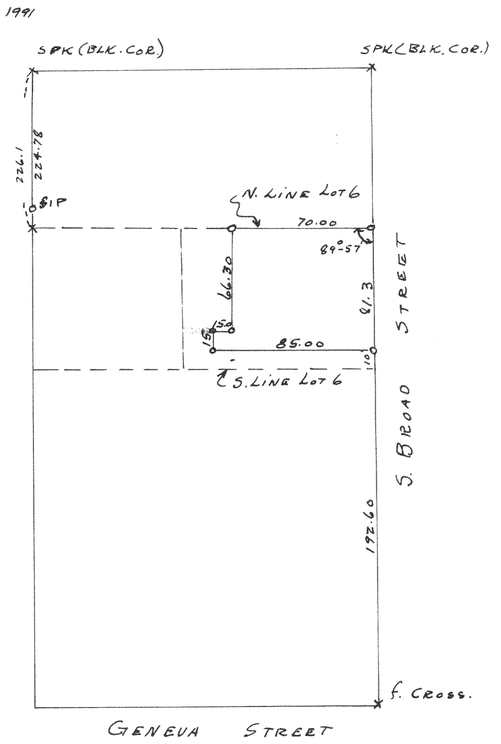

Plat of survey of part of lot 6 Blk 27 of the Original Town, City of Elkhorn, Walworth County
January 1949 Floyd L. Jensen Cty. Surv.