

1994

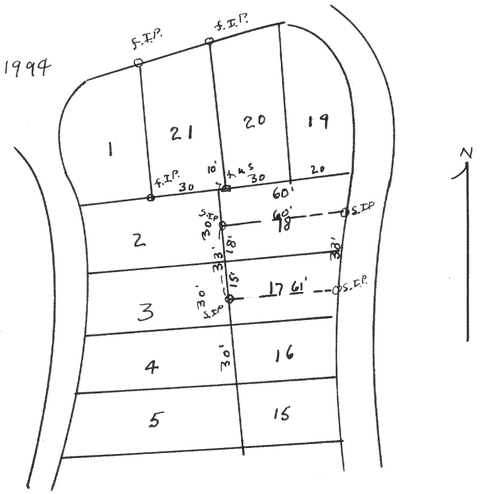

Plat of survey of the N½ Lot 17 & the south 18' of lot 18 in Block O assembly Park on Delavan Lake located in Section 21 T2N R16E of Walworth County Wisc
July 17 1948

Lloyd S Jensen
County Surveyor

1995

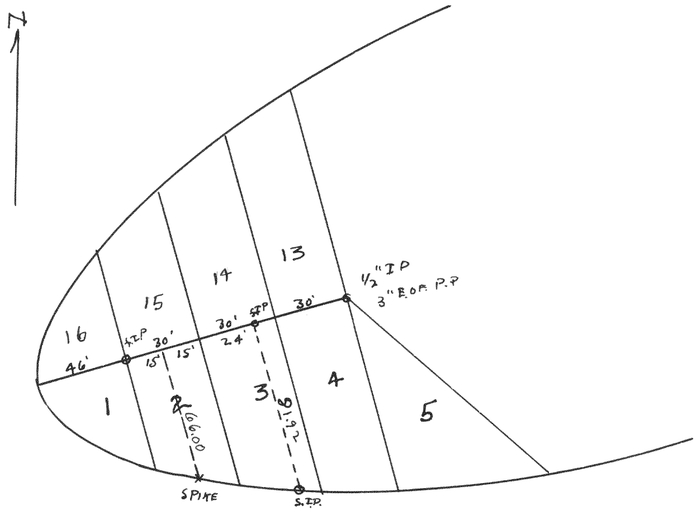

Plat of survey of 15' of lot 2, 24' of Lot 3, Block "M" in assembly Park Subdivision located in Section 21 T2N R16E Walworth County Wisconsin
July 17, 1948

Lloyd S Jensen
County Surveyor