
1996

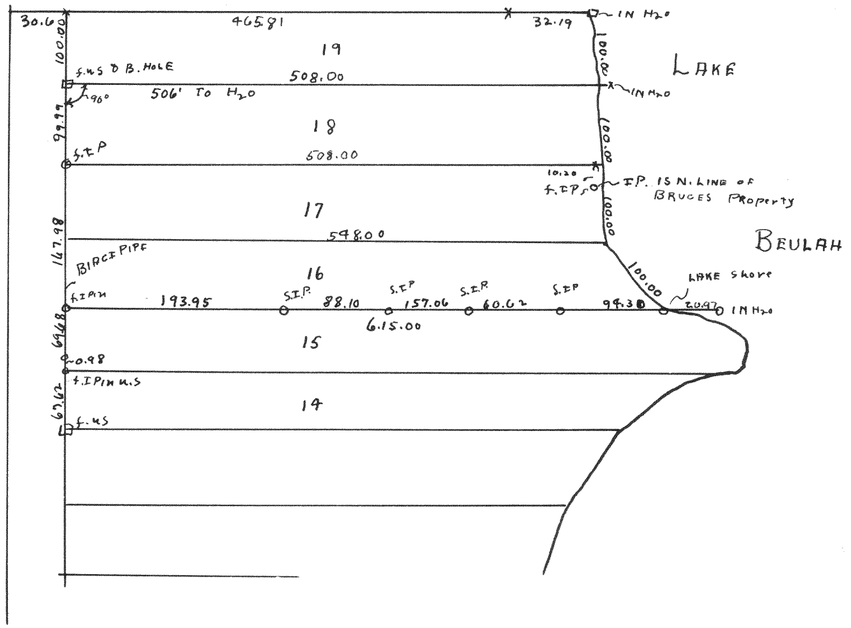

Plat of survey of the line between lots 15 & 16 of Romaika Park at Lake Beulah T4N R18E of Walworth County Wisconsin
October 20 1948


Lloyd S Jensen
County Surveyor

1997

See plat of Gutzmer's subdivision on file at the Register of Deeds office Elkhorn Wis
1948

Lloyd S Jensen
County Surveyor

#1998

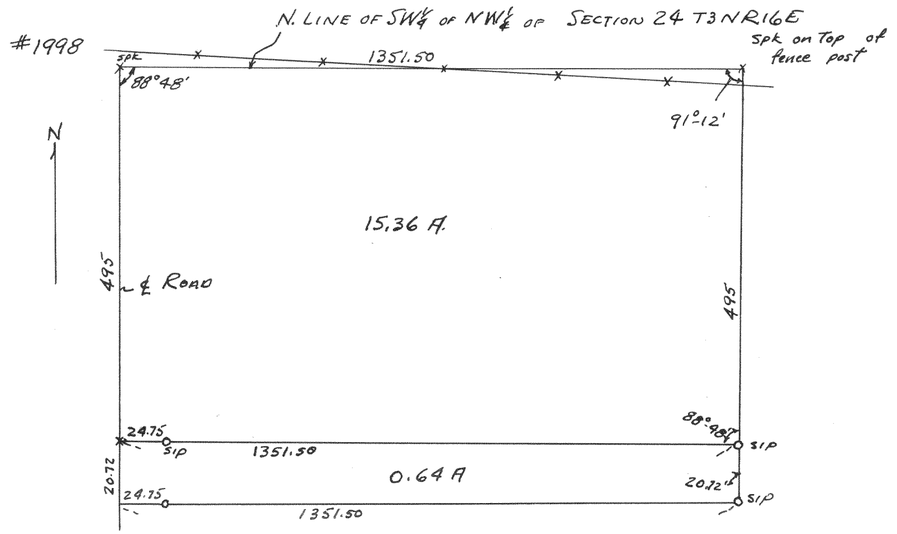

Plat of survey of a parcel of land located in the SW¼ of the NW¼ of Section 24 T3N R16E
March 20, 1947

Lloyd S. Jensen
County Surveyor