

#2002

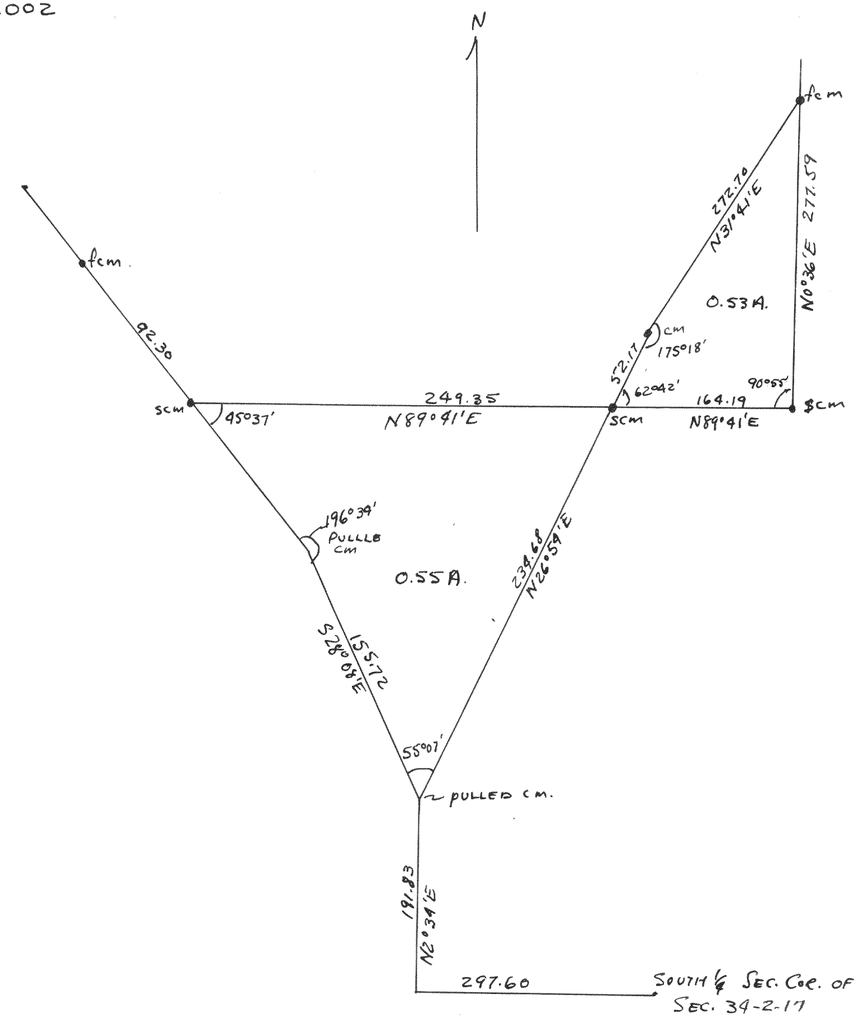

Plat of survey of parcel of land located in Sec. 34, T2NR17E of Walworth County, Wis
Jan 1949

Lloyd L. Jensen
County Surveyor
1948

#2003

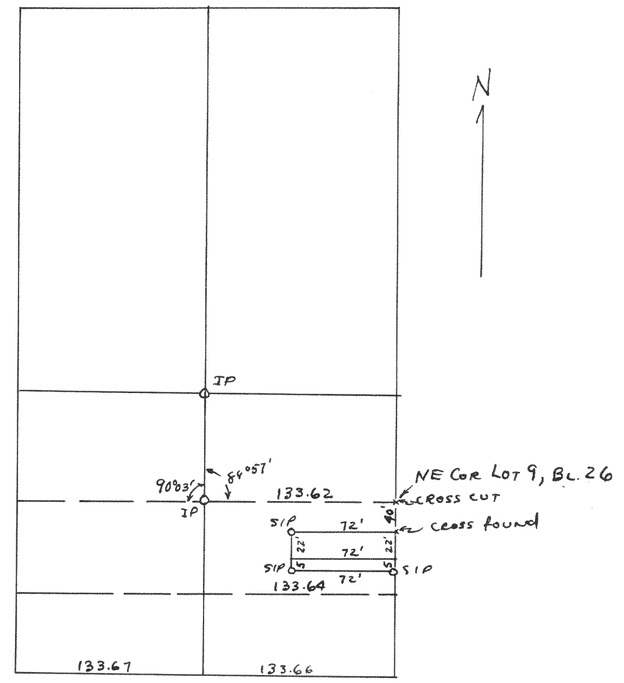

Plat of survey of a part of lot 9, Bl. 26, of the original plat, City of Elkhorn, Walworth County, Wis.
1948

Lloyd L. Jensen
County Surveyor
1948