
414

Part to here 3-10-49 LLJ

2010

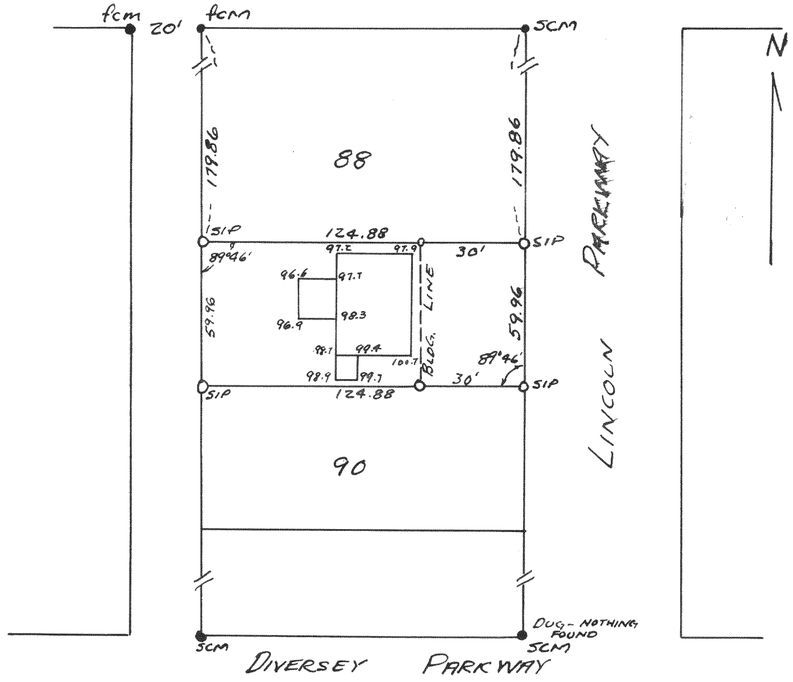

Plat of Survey of Lot 89 in the Original Cedar Point Park Subdivision in the Village of Williams Bay, Walworth County
June 23, 1948
Lloyd L. Jensen
SHC

#2020



Plat of survey of Lots 5665-5668, Lake Como Beach Subdivision located in Section 28, T2NR17E of Walworth County, Wisconsin
Feb 28 1948
Lloyd L. Jensen
County Surveyor