

2021

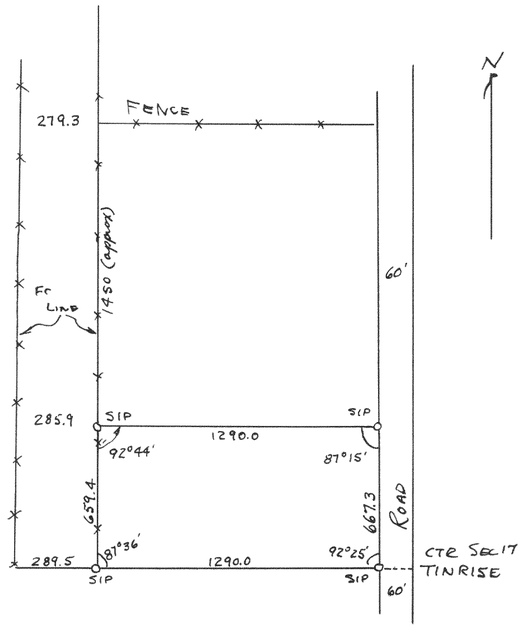

Plat of survey of a parcel of land located in the S½ of the SE¼ of the NW¼ Section 17, T1NR1SE
Aug 16, 1949

Floyd L. Jensen
County Surveyor
908

2022

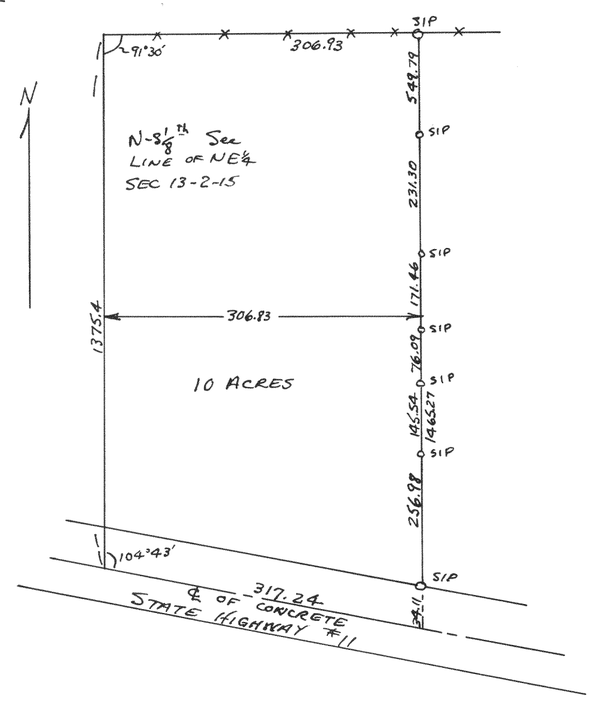

Plat of survey of a 10 Acre parcel of land located in the NE¼ of Section 13, T2NR1SE
1949

Floyd L. Jensen
County Surveyor
908