
#2023

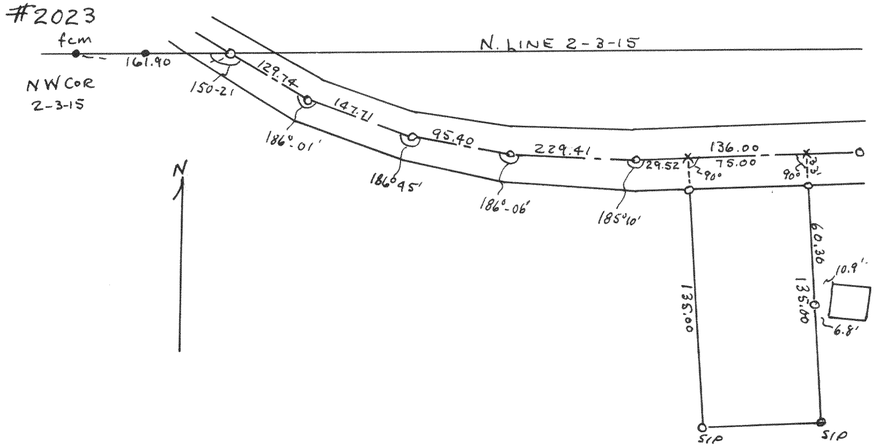


Plat of survey of a parcel of land located in the Northwest Corner of Section 2, T3NR15E

April 5, 1949

Lloyd L. Jensen
County Surveyor
JLB

2024

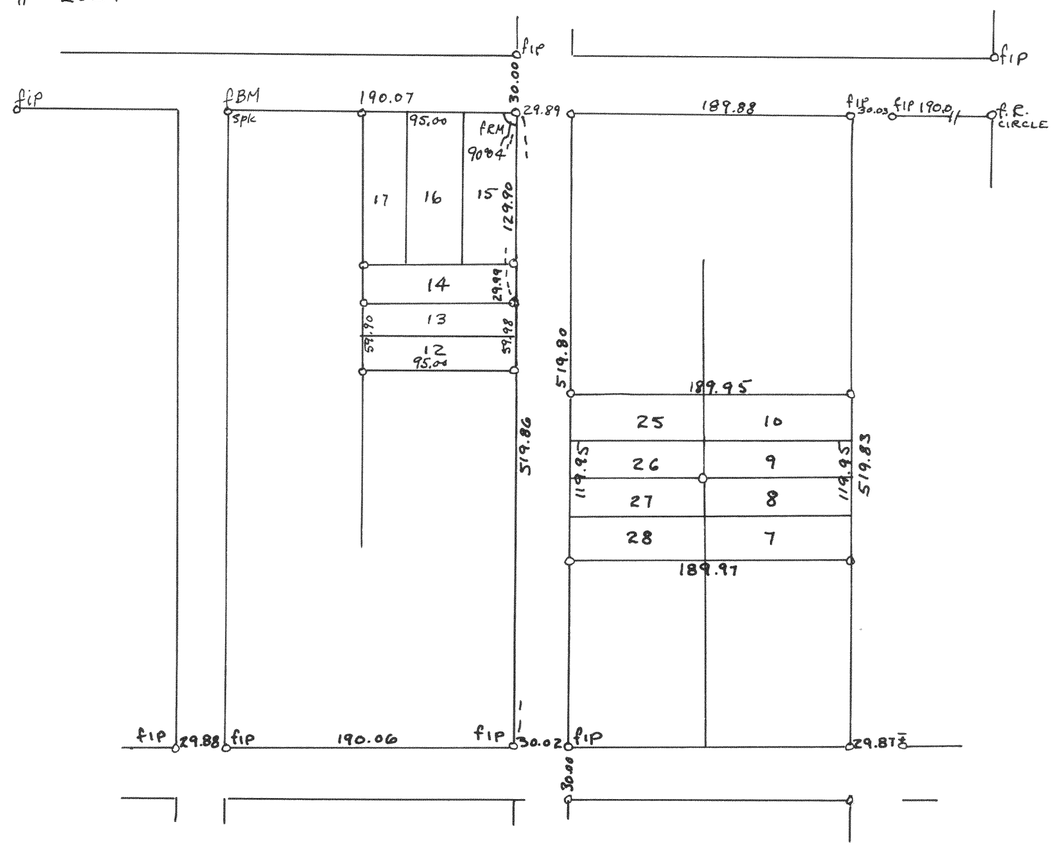

Plat of Survey of lot 12, 13, 14, 15, 16, & 17 Block 18 and 7-10, 25-28 Block 19 Skansen Subdivision located in SW¼ Section 9, T3NR15E
May 4, 1949

Lloyd L. Jensen
County Surveyor
JLB