

2025

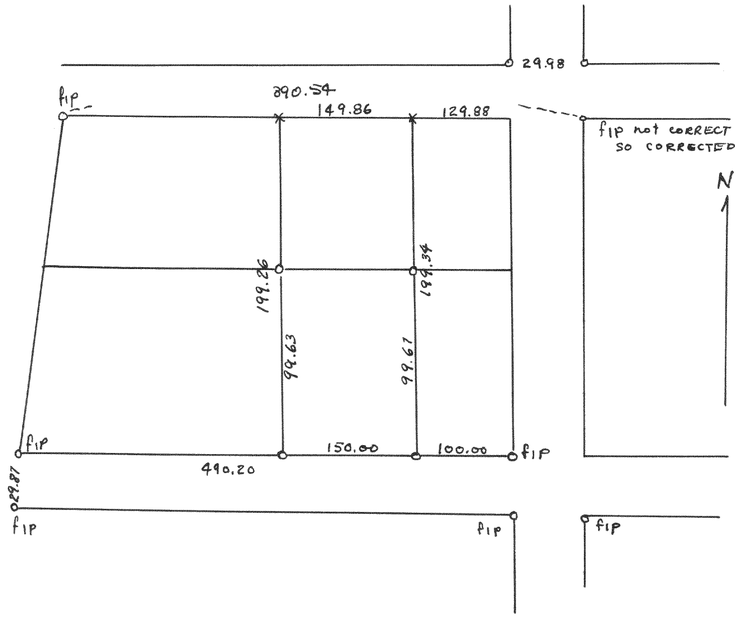

Plat of survey of Lots 6-10 Block 14 of Skansen Subdivision located in SW¼ Section 9, T3NR15E
1949

Lloyd L. Jensen JRB
County Surveyor


2026

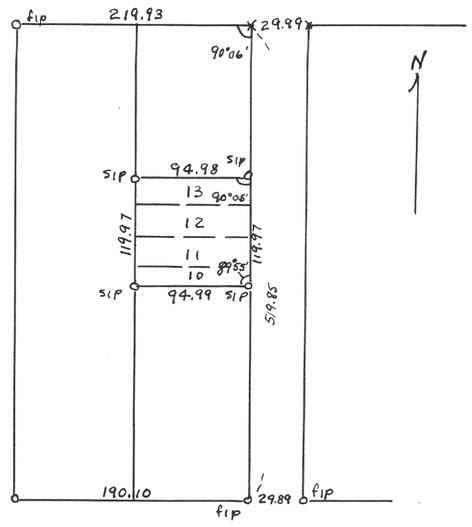

Plat of survey of Lots 10-18 Bl 17 of Skansen subdivision located in SW¼ Sec 9, T3NR15E
May 6, 1949

Lloyd L. Jensen JRB
County Surveyor


2027

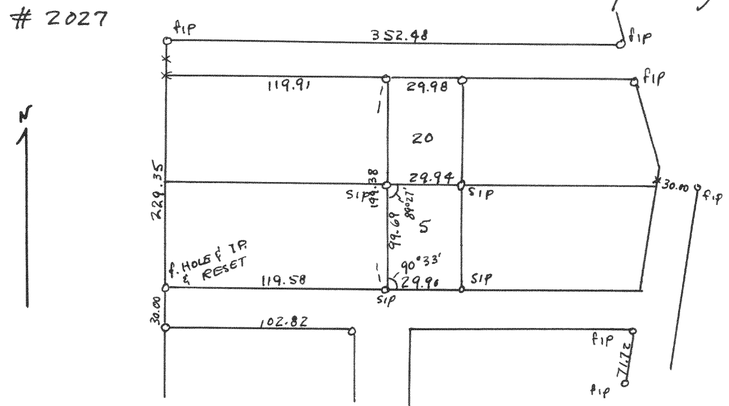

Plat of Survey of Lots 5 & 20 Block 10 of Skansen Subd. located in SW¼ Sec 9, T3NR15E
Sept 13, 1949

Lloyd L. Jensen JRB
County Surveyor

2028

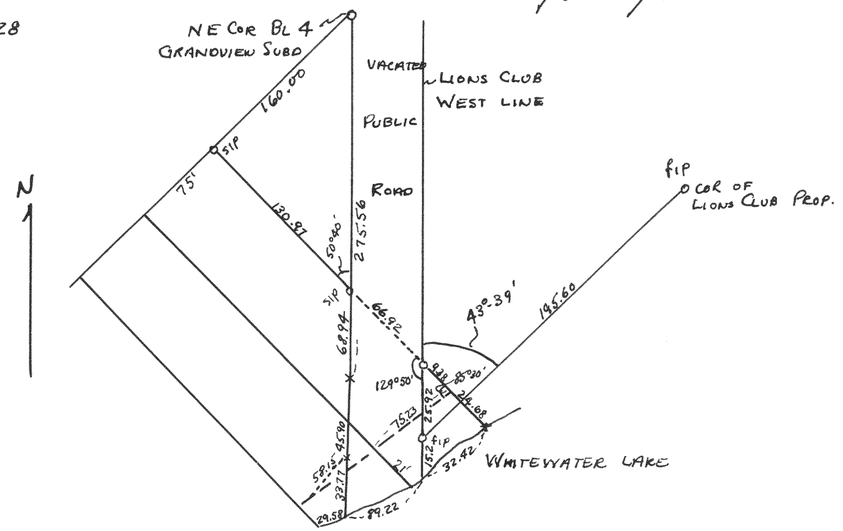

Plat of survey of parcel of land located in the SW¼ of Sec. 34, T4NR15E
Oct 7, 1949

Lloyd L. Jensen JRB
County Surveyor