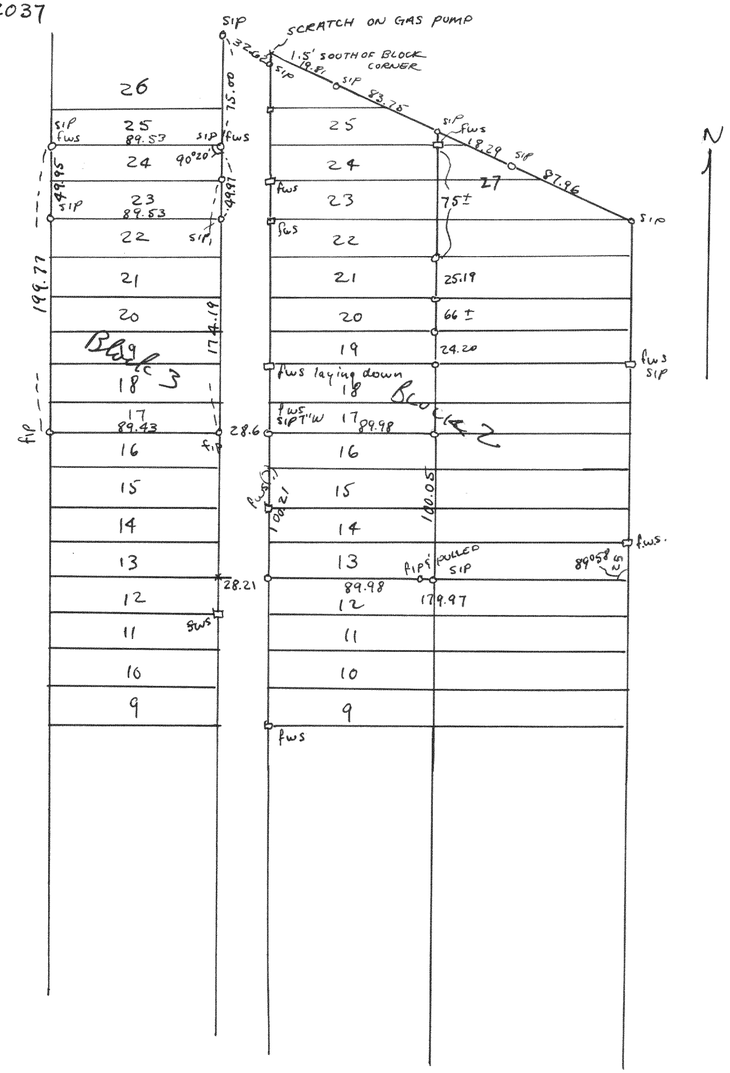
422

#2037


SIP
SCRATCH ON GAS PUMP
1.5' SOUTH OF BLOCK CORNER
SIP
SIP
SIP