
424

#2041

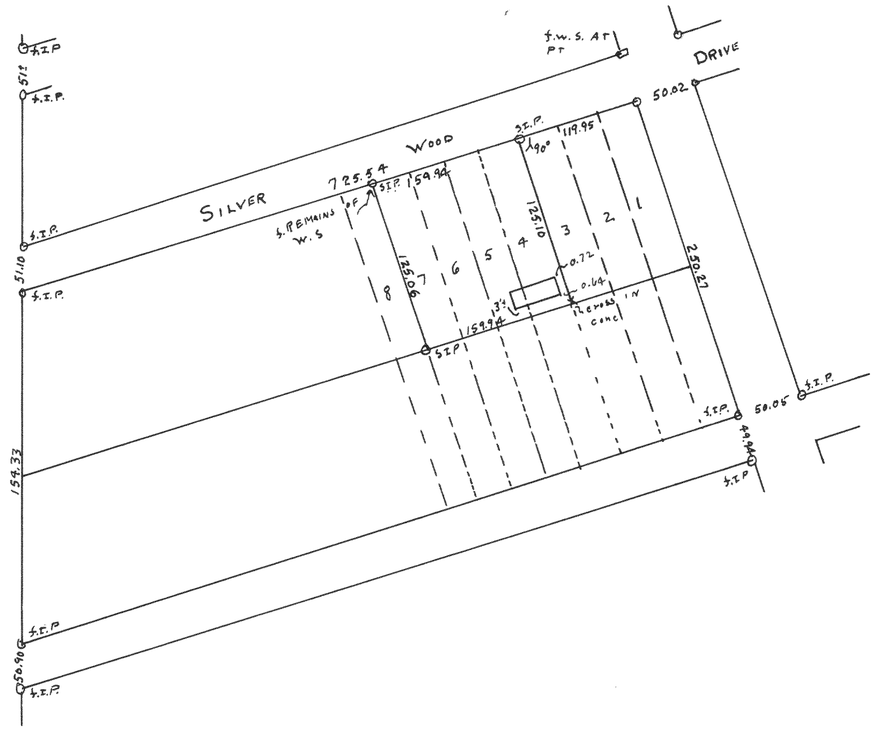


Plat of survey of lots 4-7 Block 15 of Delavan Lake View Crest Subdivision located in Sec 31, T2NR16E

Oct 17, 1949

Lloyd L. Jensen Jr
County Surveyor

#2042

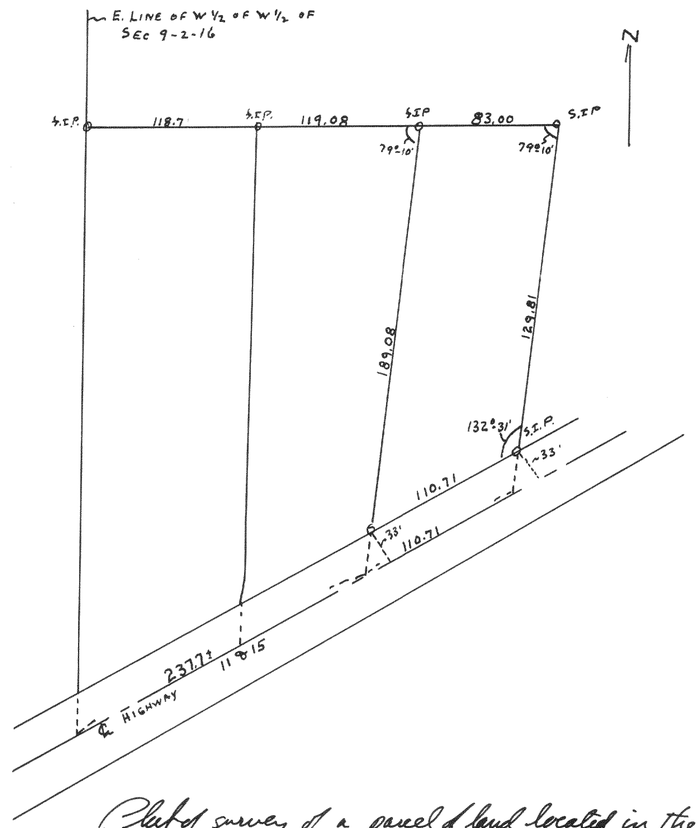

Plat of survey of a parcel of land located in the E ½ of the W ½ of Sec 9, T2NR16E

Oct 18, 1949

Lloyd L. Jensen
County Surveyor