
426

2046

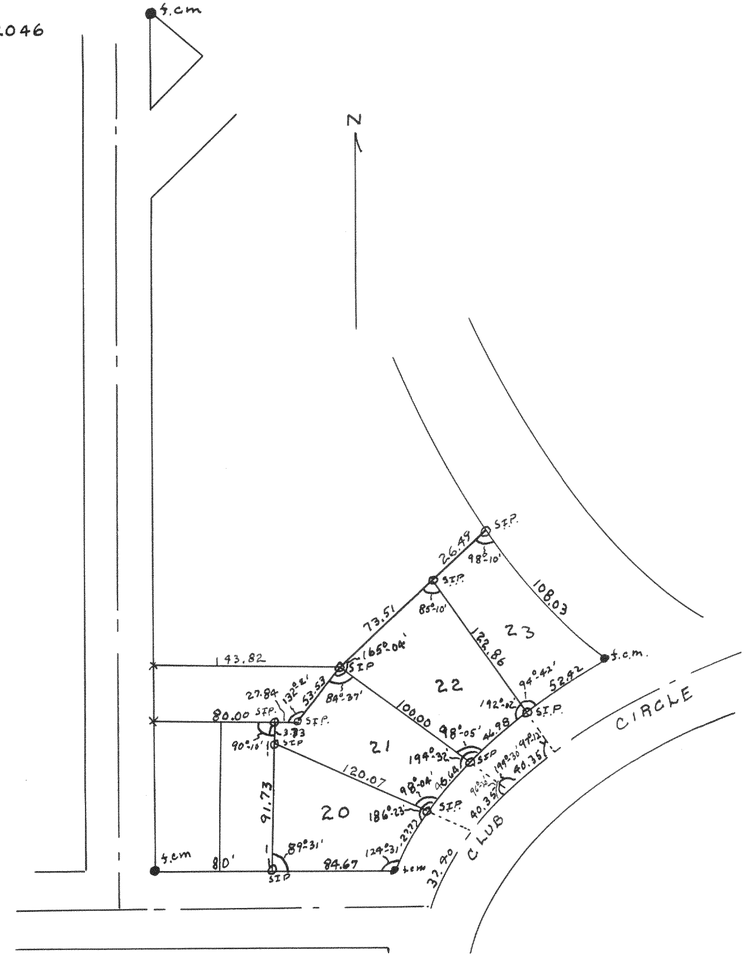


Plat of survey of lots 20-21-22-23 of Block 39 of Interlaken subdivision located in Section 11, T3NR16E Walworth County

April 26, 1999

Lloyd J Jensen

County Surveyor

#2047

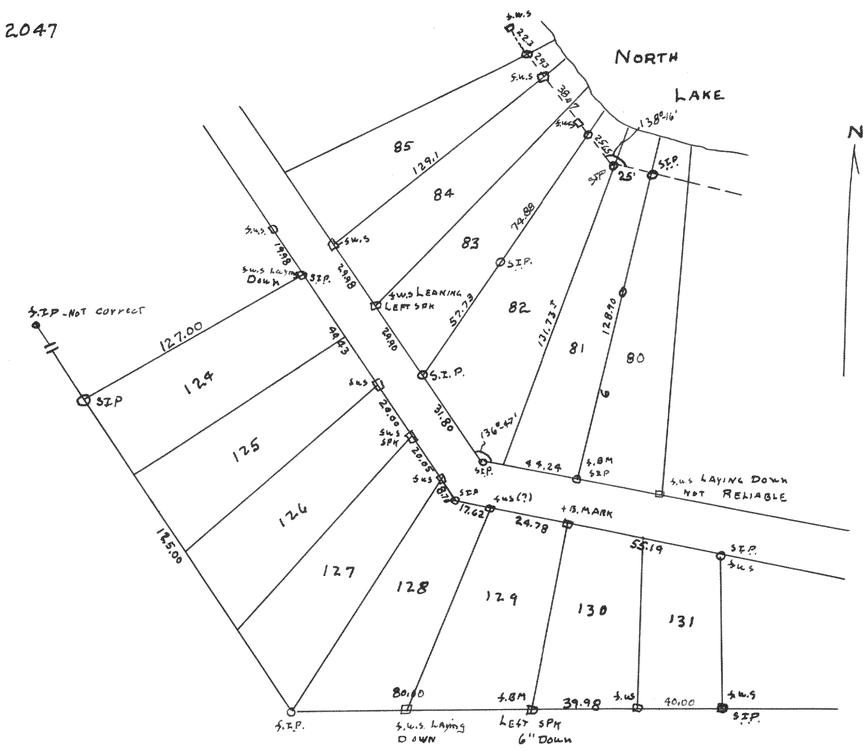

Plat of survey of lots 124-131 & 81-82 Block A "North Lake Beach Subdivision located in Section 8 T3N R16E

Sept 10, 1999

Lloyd J Jensen

County Surveyor