
2048

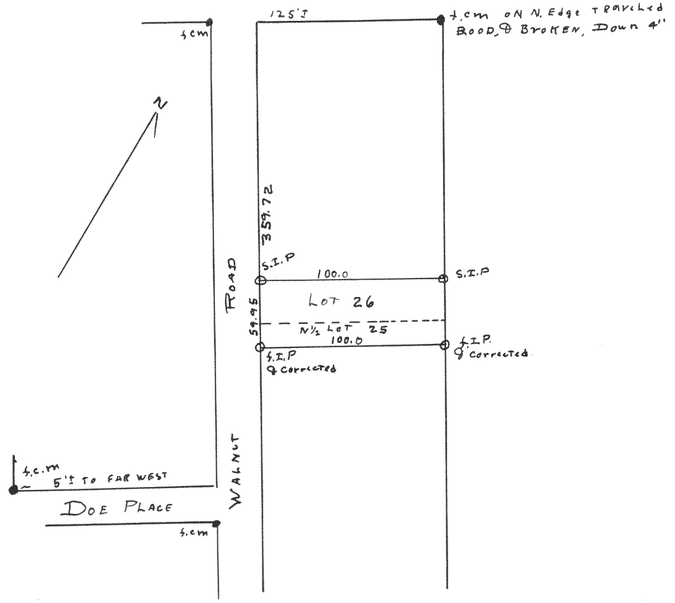


Plat of survey of N½ Lot 25 & Lot 26 of Block 63 Interlaken subdivision located in Section 11 T3N R16E Walworth County

Sept 20, 1949

Lloyd L Jensen RLS
County Surveyor

2049

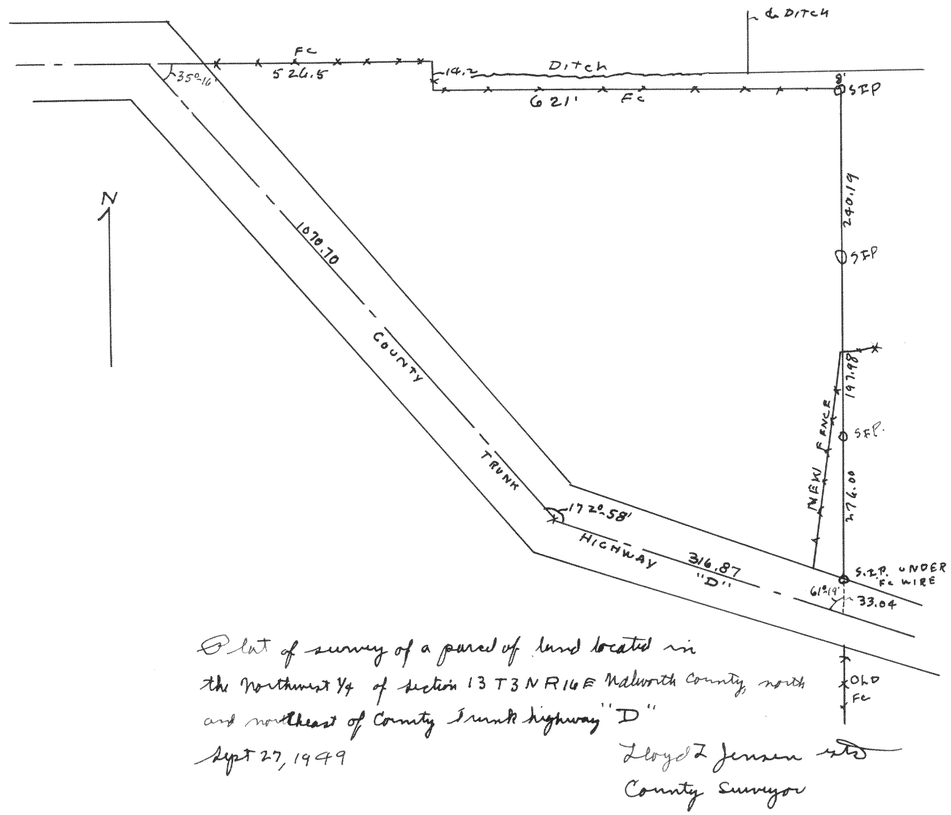


Plat of survey of a parcel of land located in the Northwest ¼ of Section 13 T3N R16E Walworth County, north and northeast of County Trunk highway "D"

Sept 27, 1949

Lloyd L Jensen RLS
County Surveyor

2050

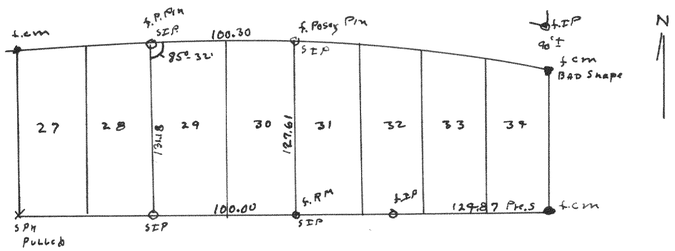

Plat of survey of lots 29 & 30 of Block 7 Mandawegan Highlands located in Sections 1 & 12 T3N R16E

Oct 31, 1949

Lloyd L Jensen RLS
County Surveyor