

#2051

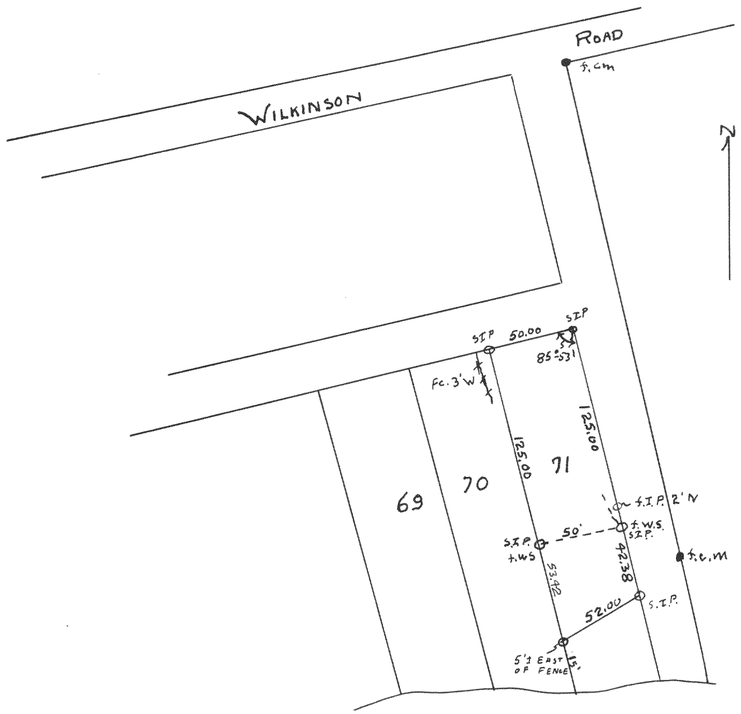

Plat of survey of lot # 71 Sandsdale Heights located in the SW 1/4 Section 36 T4N R1E Walworth County
April 20, 1949

Lloyd L. Jensen
County Surveyor

#2052

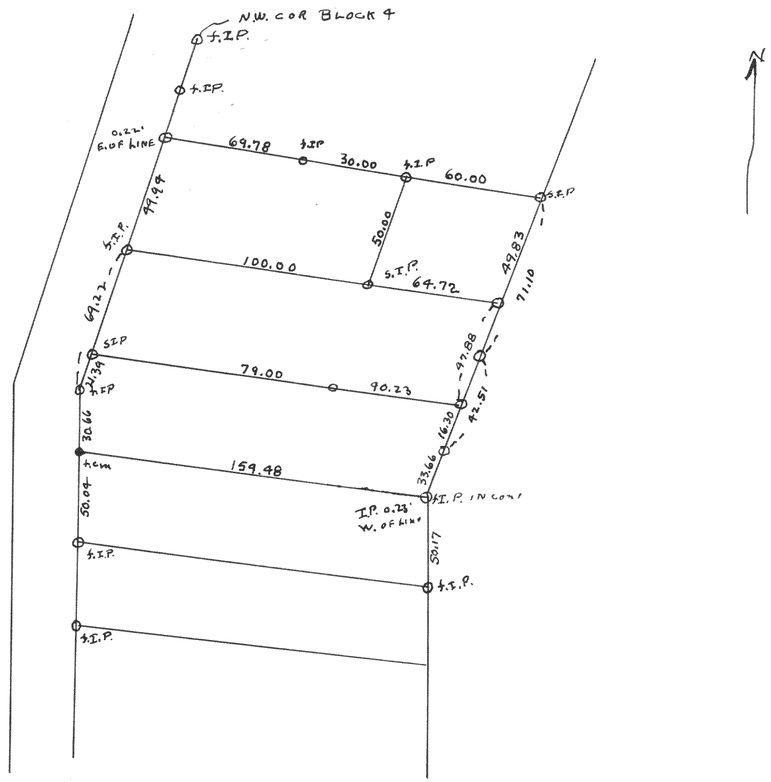

Plat of survey of a parcel of land located in Block 4 of Green Lake Beach subdivision located in the SW 1/4 of Section 26 T4N R16E Walworth County,
1949

Lloyd L Jensen
County Surveyor