2053

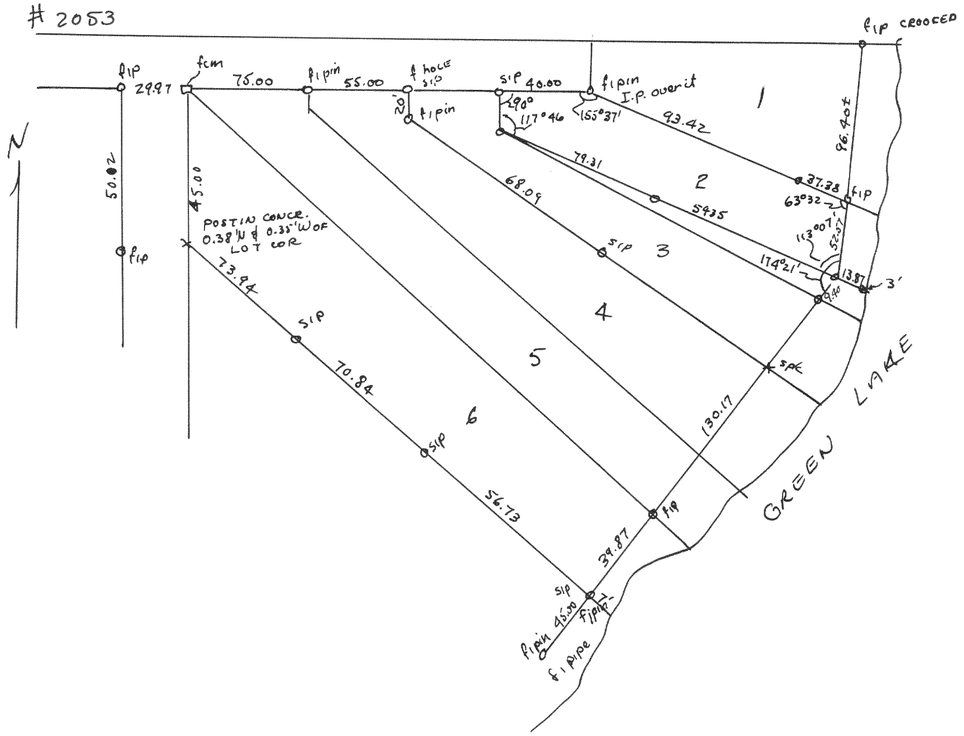

Plat of survey of lots 1-6 of Froedtert's Green Lake Park located in the NW¼ of Section 26 T9NR16E
May 20, 1949

Lloyd L. Jensen
County Surveyor

2054

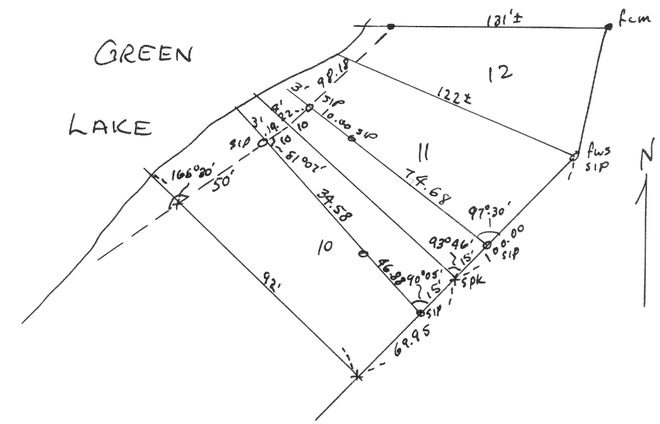

Plat of survey of parts of lots 10 & 11 of La Salle Subd located in Sec 26 T4NR16E
July 7, 1949

Lloyd L. Jensen
County Surveyor