

2053

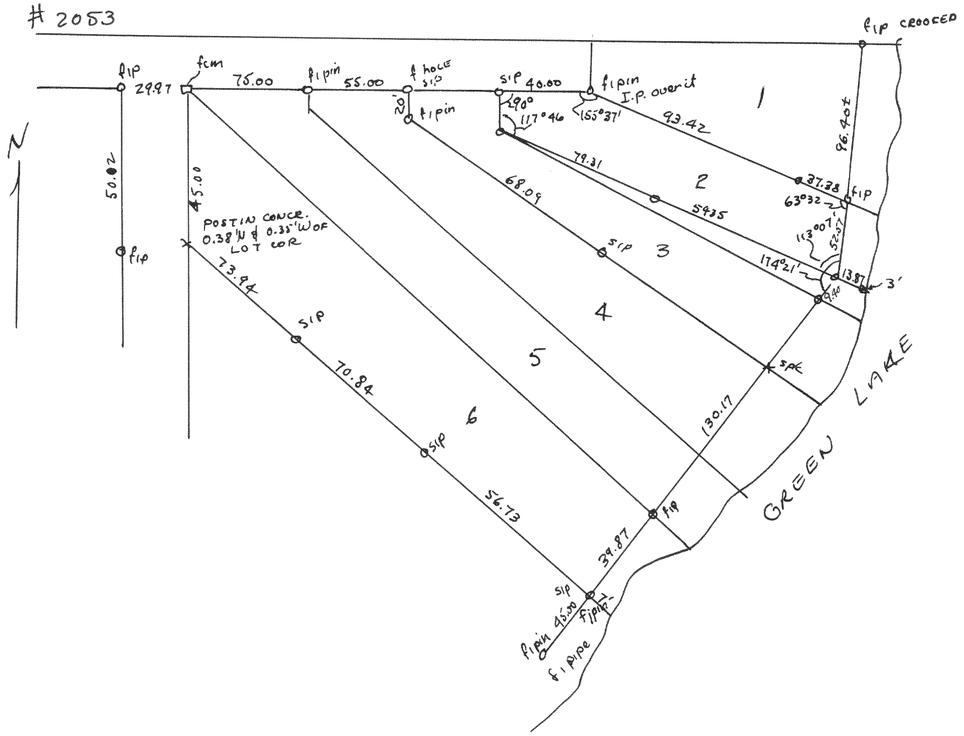

Plat of survey of lots 1-6 of Froelkers Green Lake Park located in the NW¼ of Section 26 T4NR16E
May 20, 1949
Lloyd L. Jensen
County Surveyor

2054

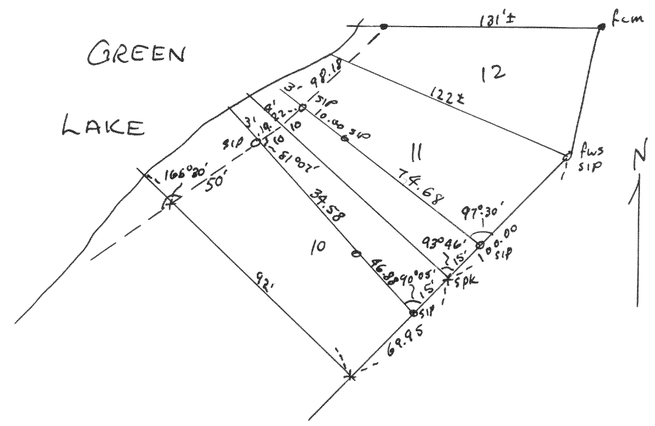

Plat of survey of parts of lots 10 & 11 of Ja Salka Subd located in Sec 26 T4NR16E
July 7, 1949
Lloyd L. Jensen
County Surveyor