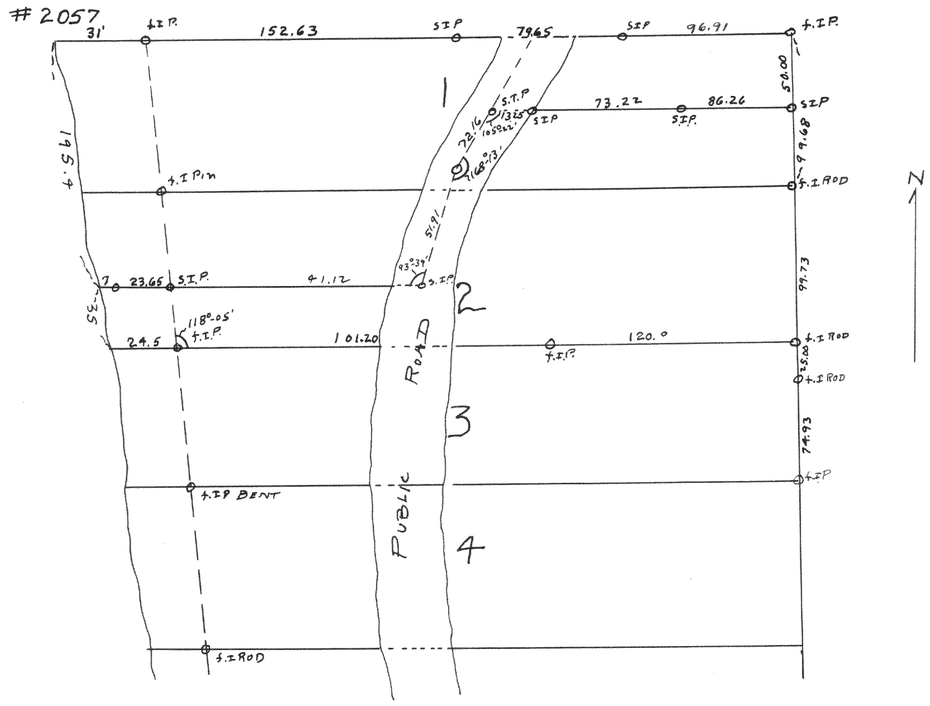

#2057
31'
I.P.
152.63
S.I.P.
79.65
96.91
I.P.
19.5'
I.P.
I.P.
I.P.