
434


#2063

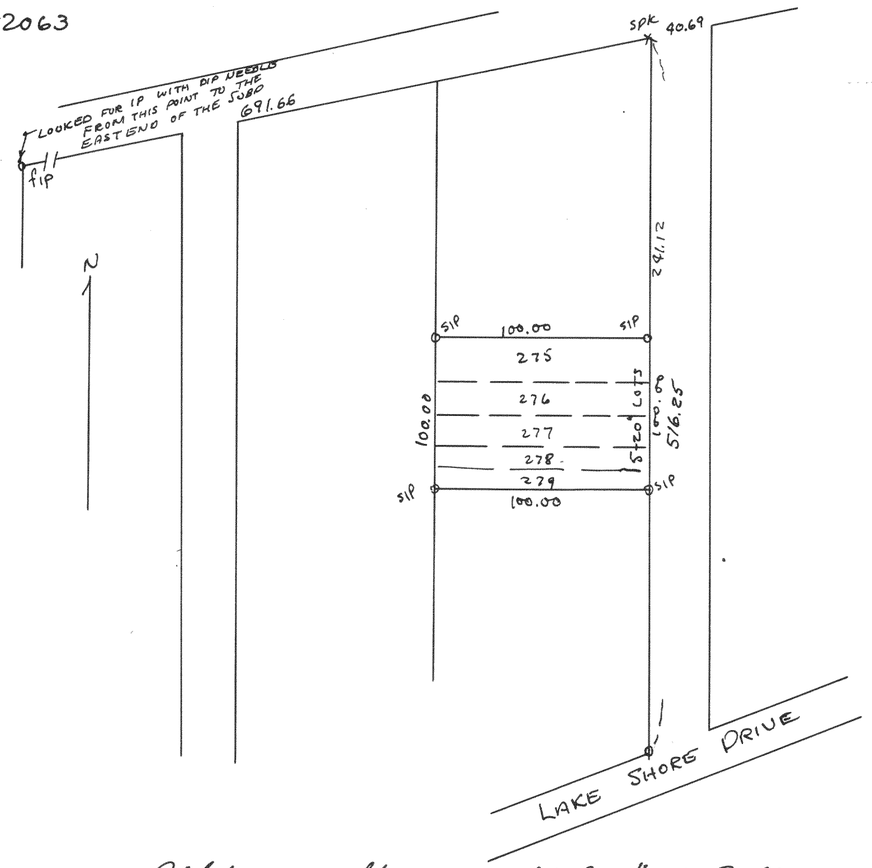

Plat of survey of lots 275-279 in Lake Como Beach Subdivision located in Secs 21 & 22, T2NR17E Walworth County, Wis.
March 4, 1949

Lloyd L. Jensen
-County Surveyor

#2064

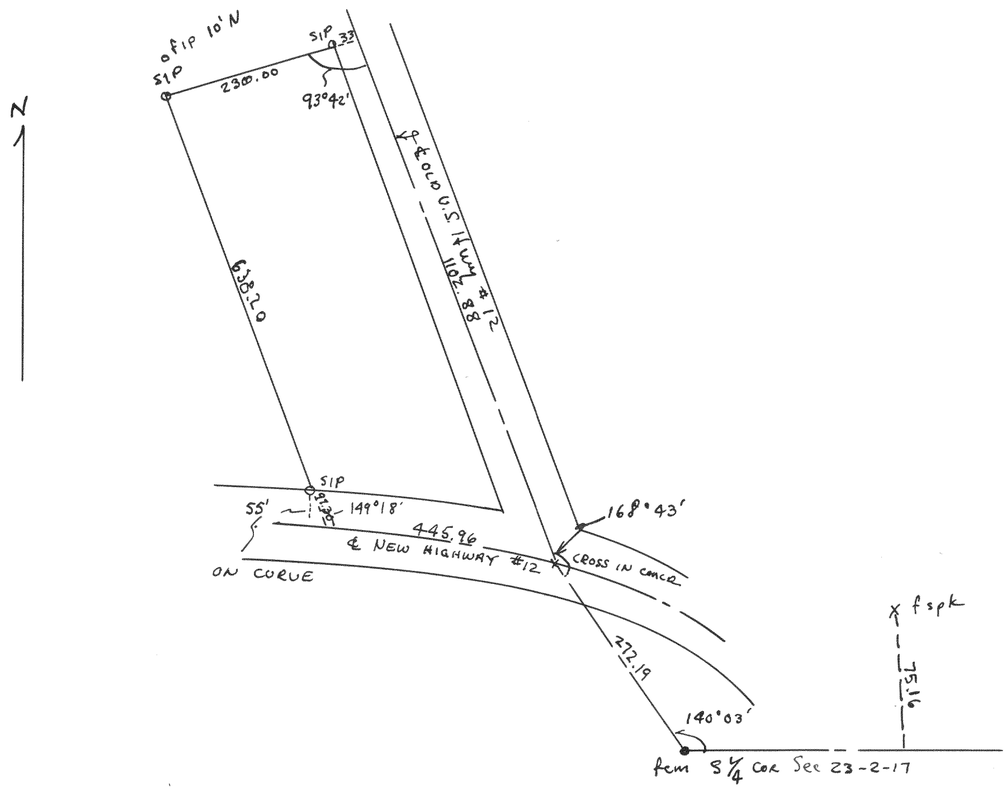

Plat of survey of a parcel of land located in the SW 1/4 of Section 23, T2NR17E, Walworth County Wis.
1949

Lloyd L. Jensen
County Surveyor