

#2065

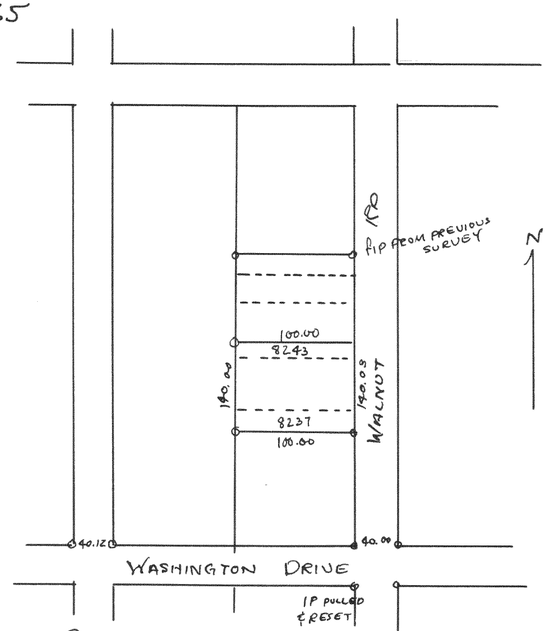


Plat of survey of Lots 8237-8243 Lake Camo Beach Subd located in Section 21 & 22 T2NR17E
April 18, 1949
Floyd L. Jensen
County Surveyor

#2066

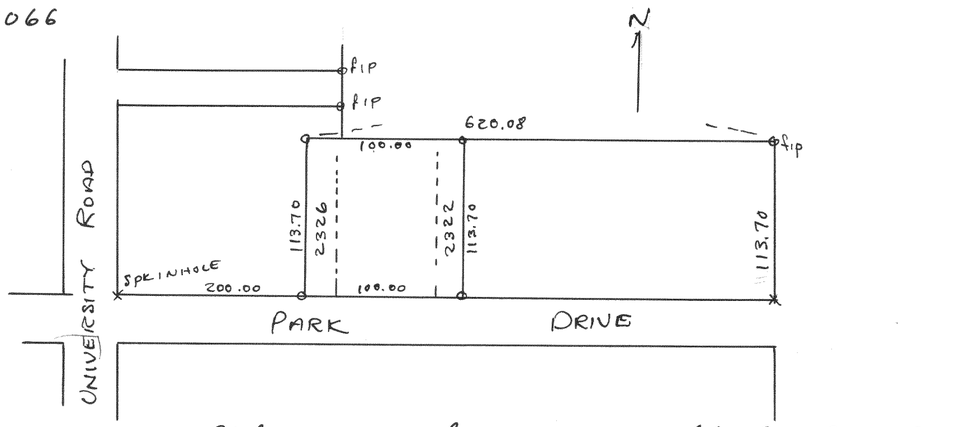


Plat of survey of Lots 2322-2326 Lake Camo Beach Subd. located in Sec 21 & 22 T2NR17E Walworth County, Wis.
May 11, 1949
Floyd L. Jensen
County Surveyor

#2067

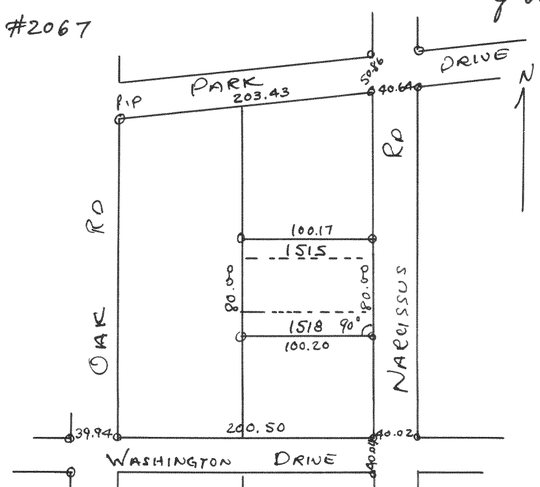

Plat of survey of Lots 1515-1518 Lake Camo Beach Subd
June 2, 1949
Floyd L. Jensen
County Surveyor

#2068

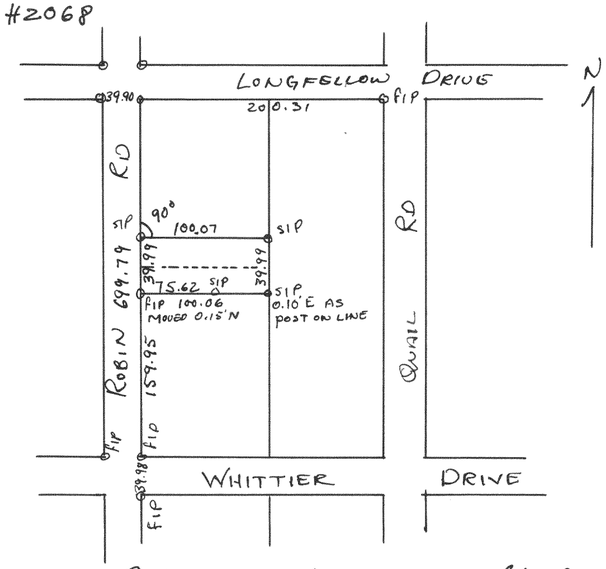

Plat of survey of Lots 8159 & 8160 Lake Camo Beach Subd located in Sec 21 & 22 T2NR17E
1949
Floyd L. Jensen
County Surveyor