

#2069

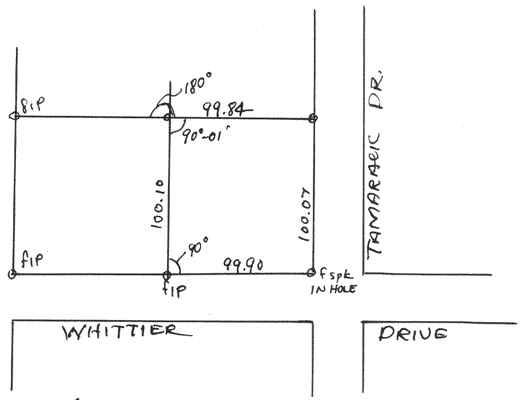


Plat of survey of lots 10388-92 Lake Lamp Beach Subd. located in Sec. 21 & 22, T2NR17E, Walworth County, Wis.
Aug 18, 1949
Lloyd L. Jensen
County Surveyor

#2070

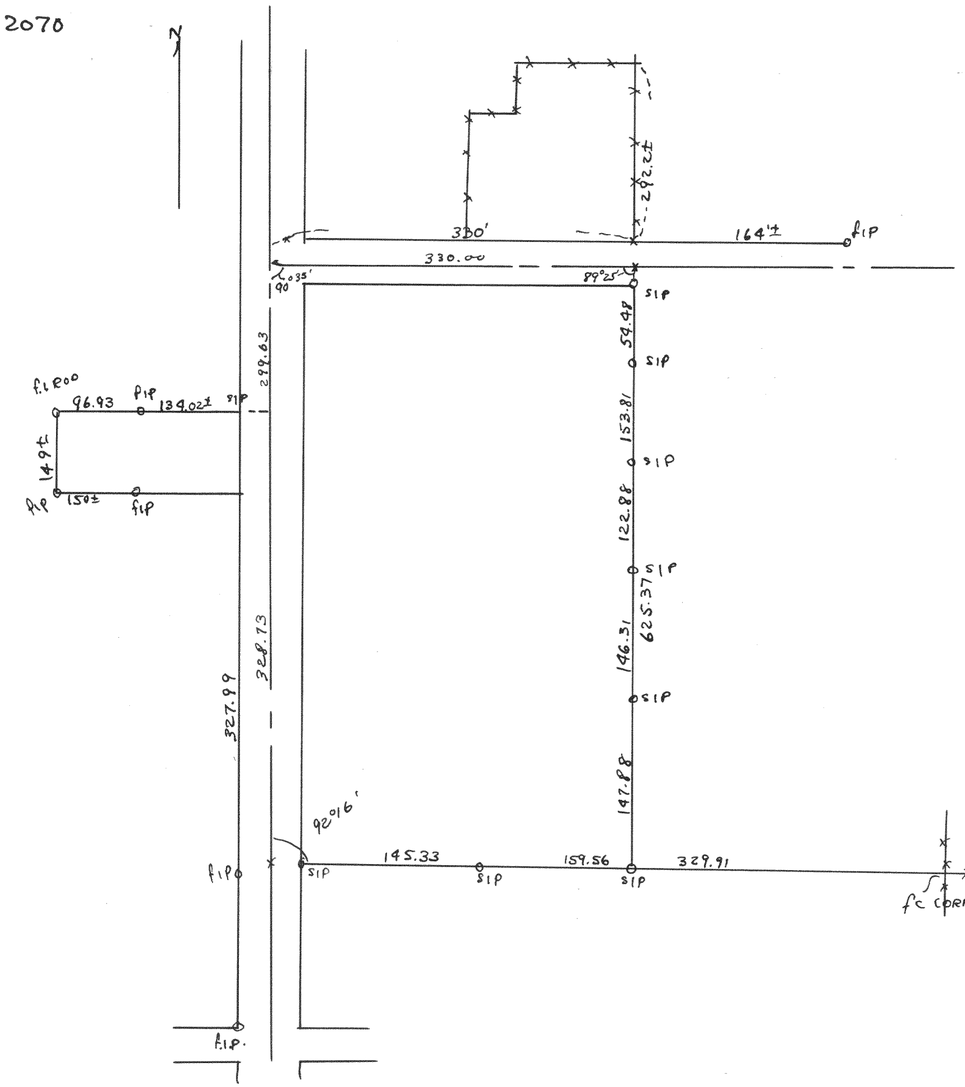

Plat of survey of the E½ of the SE¼ of the SE¼ of the SW¼ of Sec 26, T2NR17E
Aug 23, 1949
Lloyd L. Jensen
County Surveyor

#2071

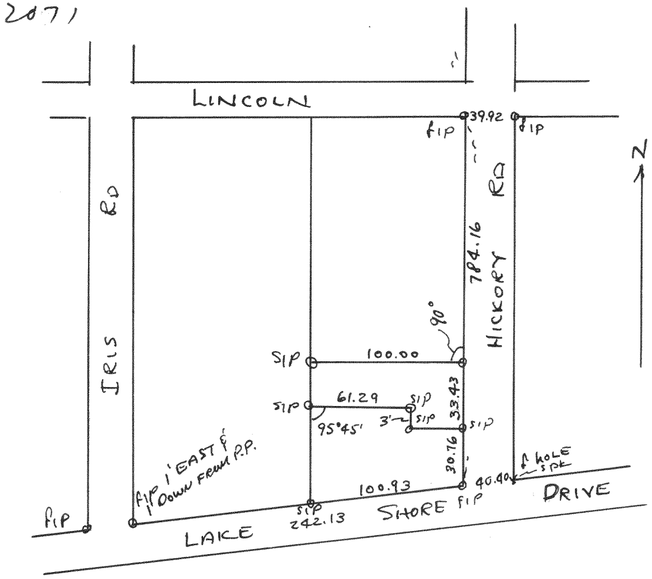

Plat of survey of Lots 6013-6017 Lake Lamp Beach Subd. located in Sec 21 & 22, T2NR17E, Walworth Co, Wis.
Aug 27, 1949
Lloyd L. Jensen
County Surveyor