

#2072

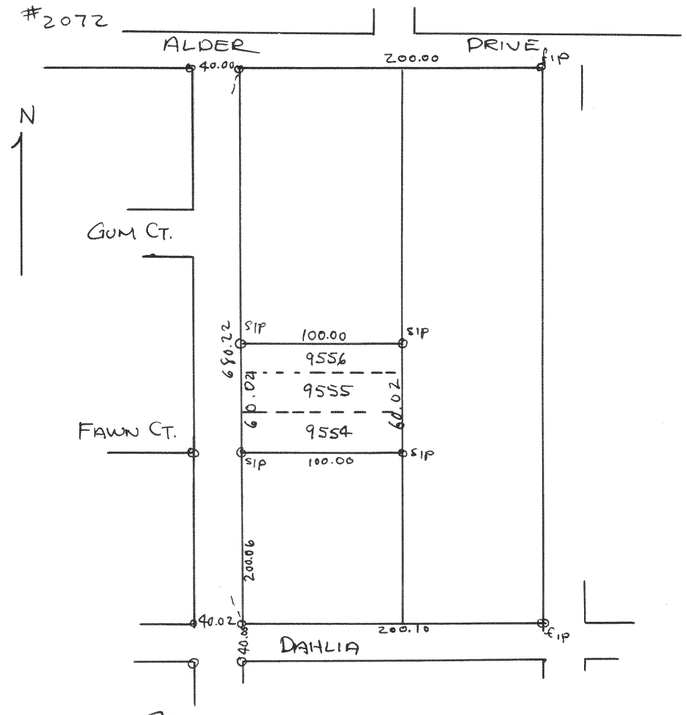

Plat of survey of lots 9554-9556 Lake Como Beach Subd located in Sec 21 & 22 T3NR17E Wal. Co. Wis.
Sept. 1, 1949
Lloyd L. Jensen
County Surveyor

#2073

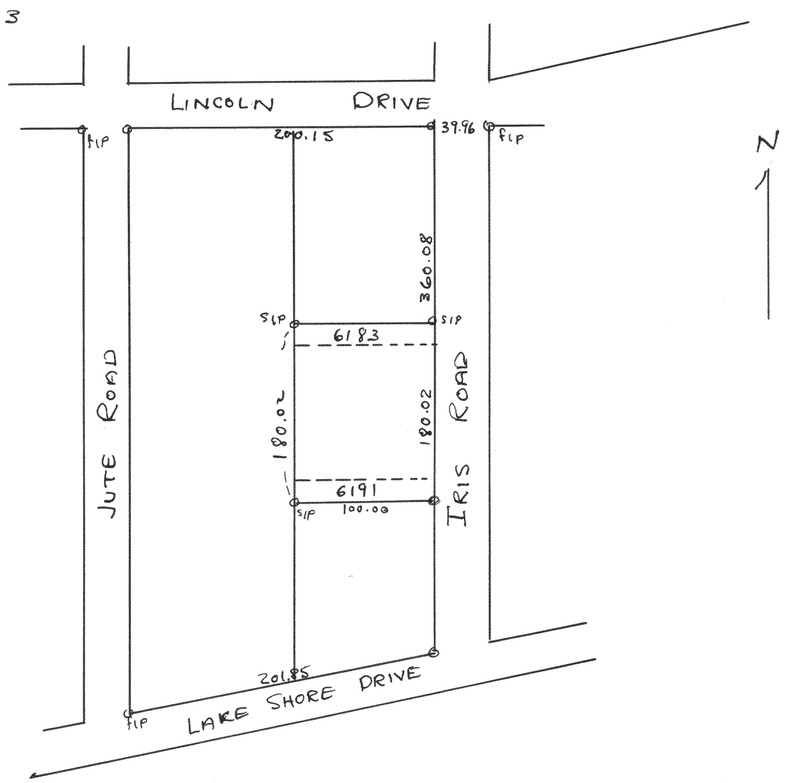

Plat of survey of lots 6183 - 6191 Lake Como Beach Subd located in Sec 21 & 22, T3NR17E, Wal. Co. Wis.
Jan 17, 1950
Lloyd L. Jensen
County Surveyor