

2075

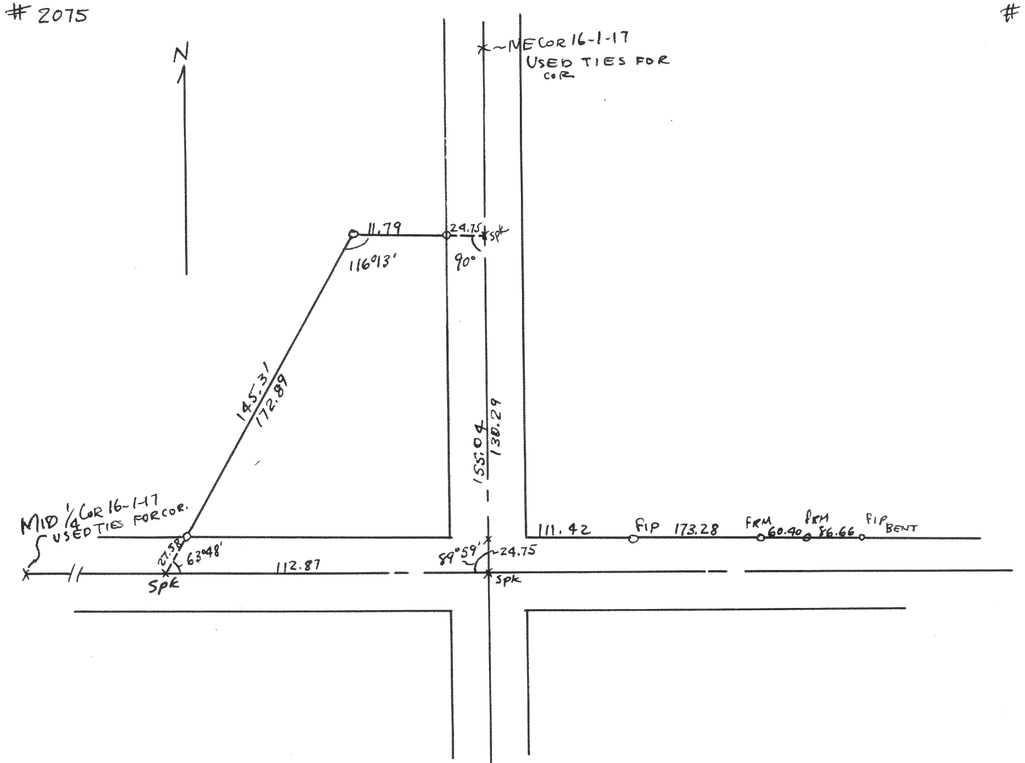

Plat of survey of a parcel of land located in the NE 1/4 of Sec. 16 T1N R17E of Walworth Cty., Wis.
June 24, 1949

Lloyd L. Jensen
County Surveyor

2076

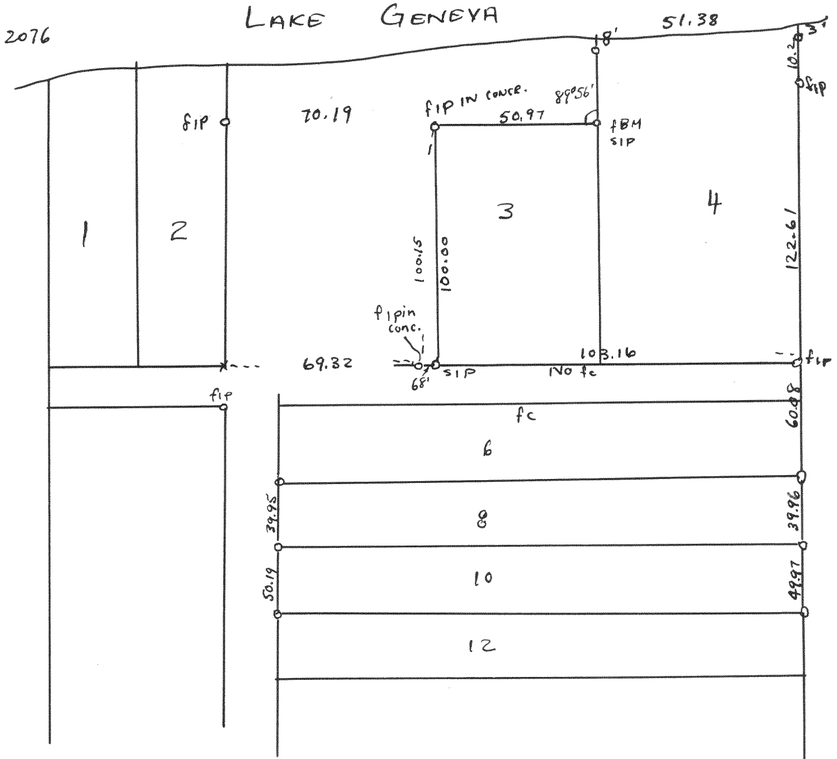

Plat of survey of lots 3 & 4 of Shore Haven Subd. located in the NE 1/4 Sec. 18 T1N R17E Walworth Cty, Wis.
June 26, 1949

Lloyd L. Jensen
County Surveyor