

#2077

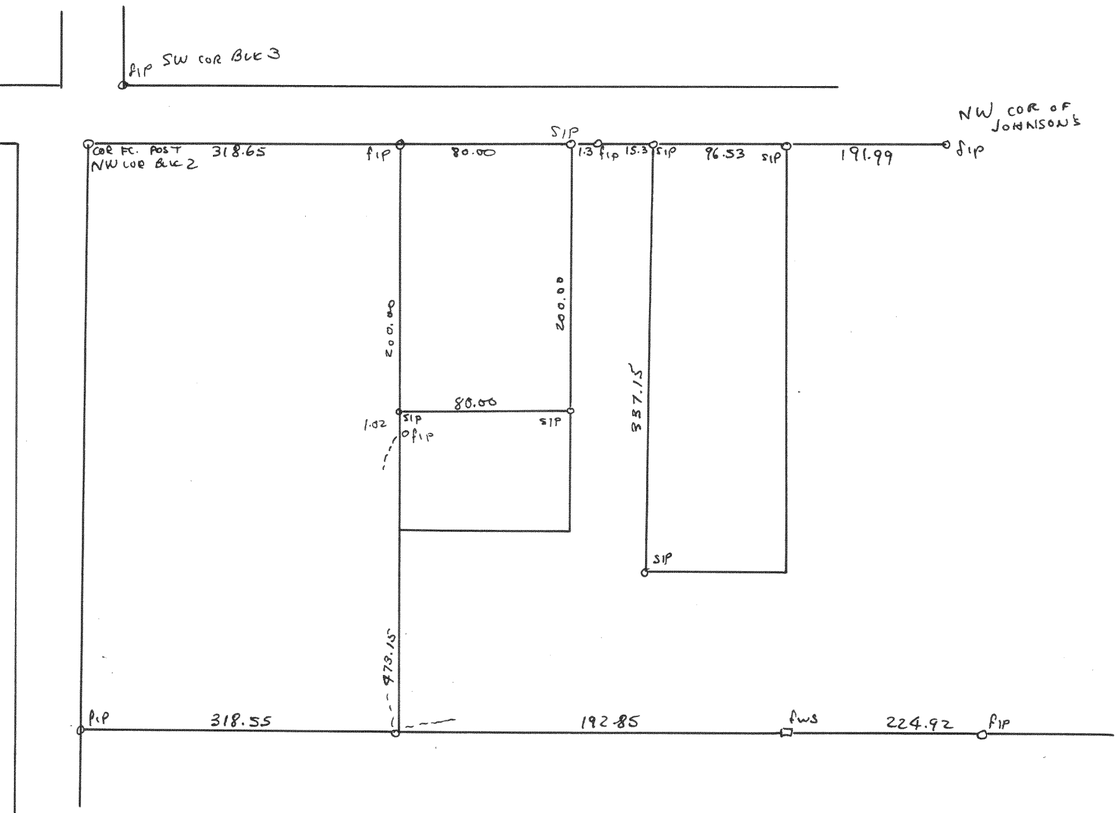

Plat of survey of parcel of land located in Block 2 of Rowena Park located in Sec 5, T1N R17E Walworth Co., Wisconsin
Oct 1949

Lloyd L. Jensen
County Surveyor

#2078

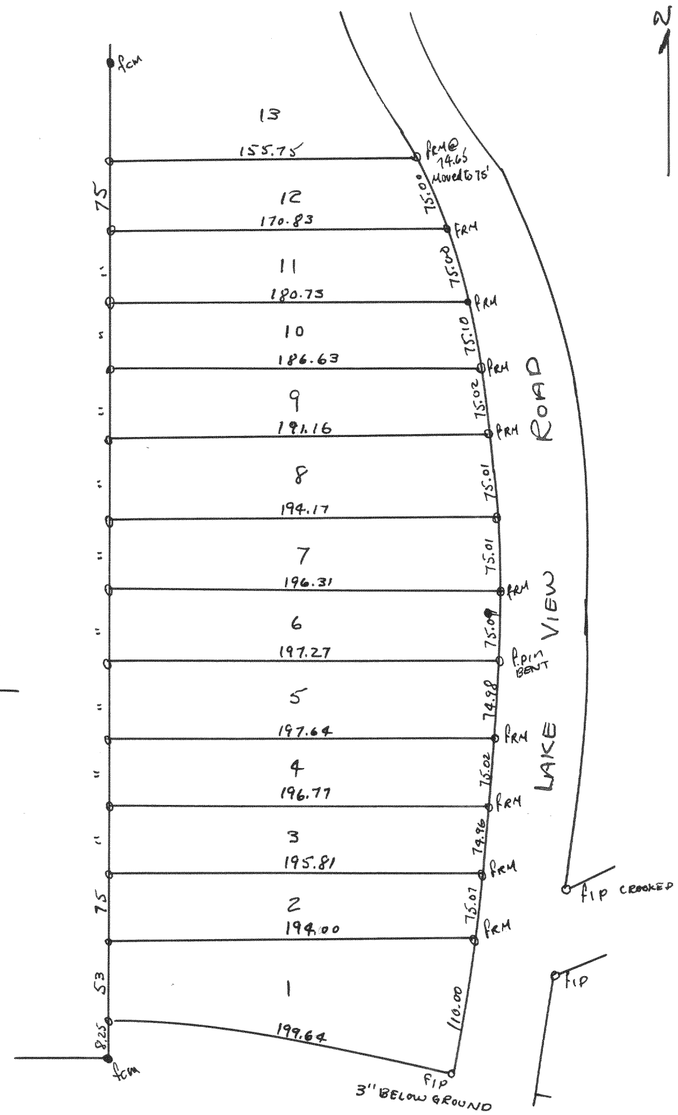

Plat of survey of lots 1-13 Block 6 Woodale Addition located in Section 9, T1N R17E
April 12, 1949

Lloyd L. Jensen
County Surveyor