

2079

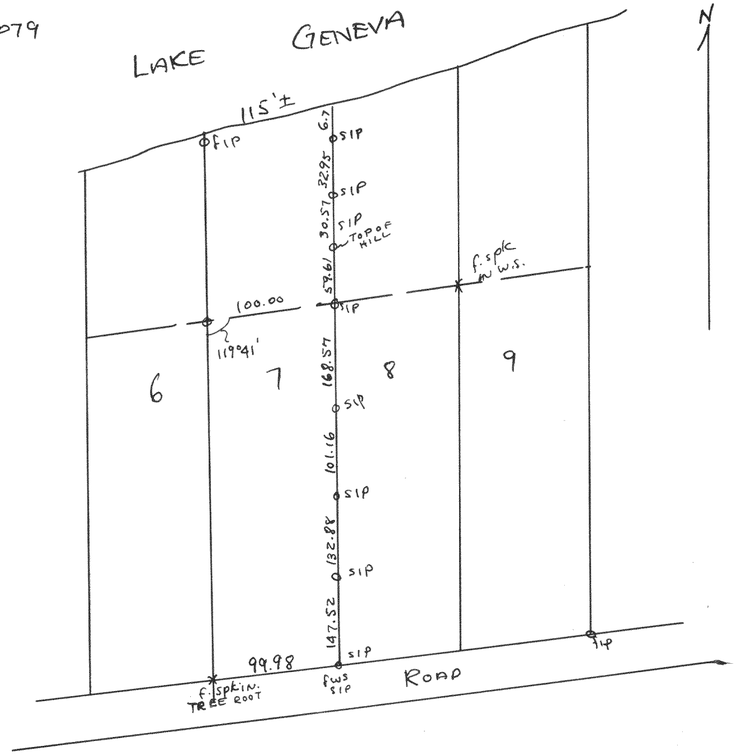

Plat of survey of line between Lots 7 & 8 of The Birches Addition located in Sec 10, TINRITE Walworth Co., Wis
May 10, 1949

Lloyd L. Jensen
County Surveyor

2080

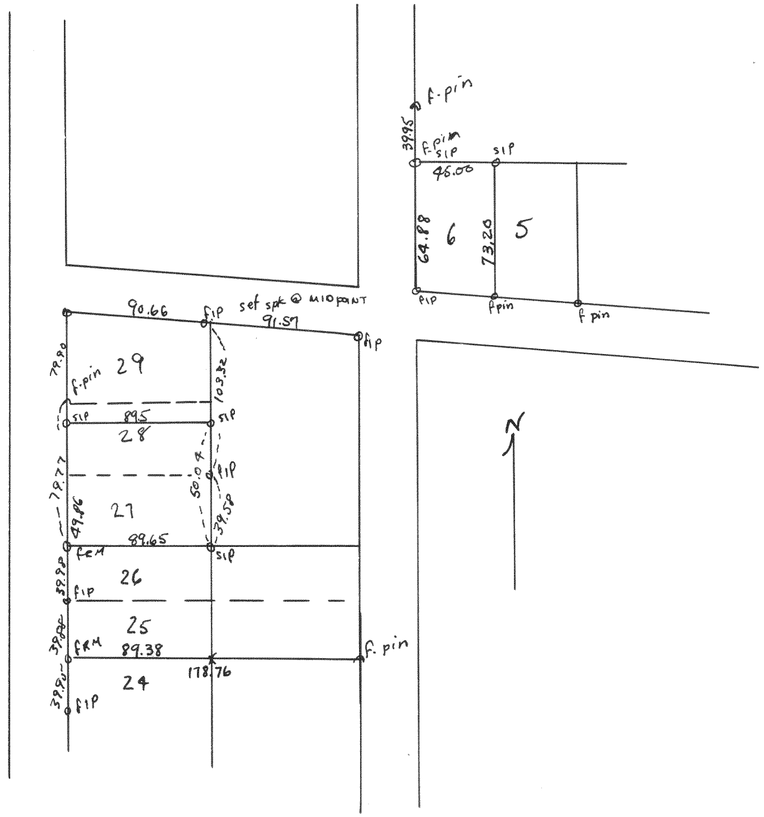

Plat of survey of Lot 6 Block I & Lot 27 and South 10' of Lot 28 Block C, Asco Beach Subd. located in Sec 5, TINRITE, Walworth County, Wis.
June 20, 1949

Lloyd L. Jensen
County Surveyor