
2087

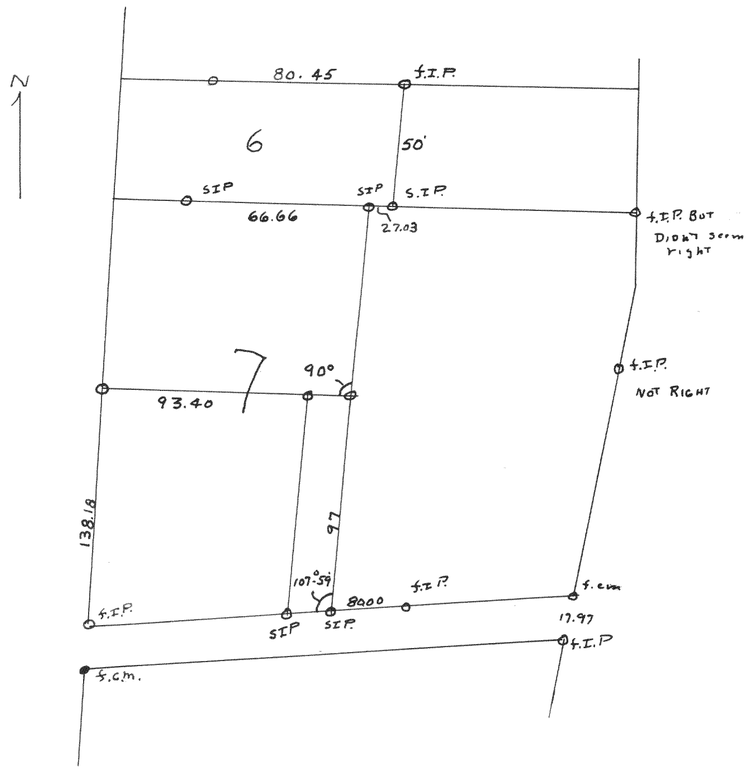


Plat of survey of lots 6 & 7 of Zudde Subdivision located in section 13, T1N R1BE of Walworth County

April 16, 1949

Lloyd L. Jensen RLS
County Surveyor

2088

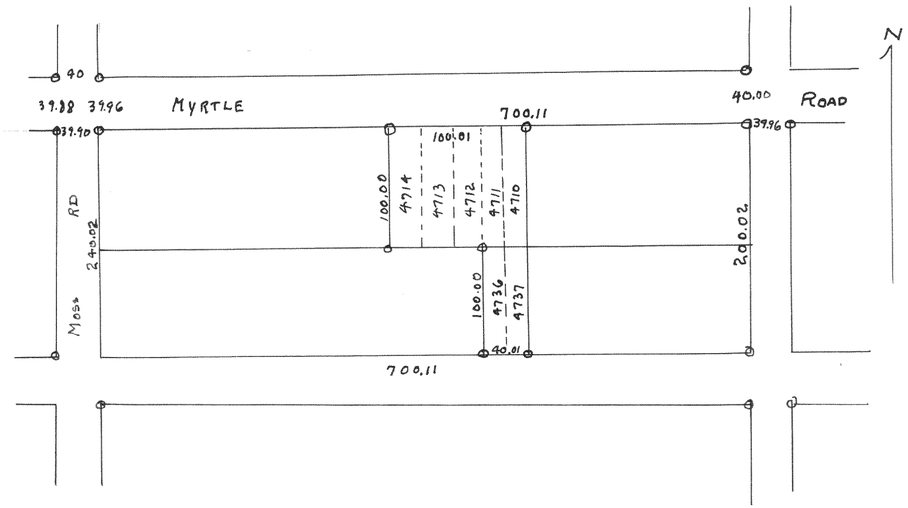


Plat of survey of lots 4736-7 & 4710 - 4714 Section 3 of Bell Lake Subdivision Walworth County

May 7, 1949

Lloyd L Jensen RLS
County Surveyor

2089

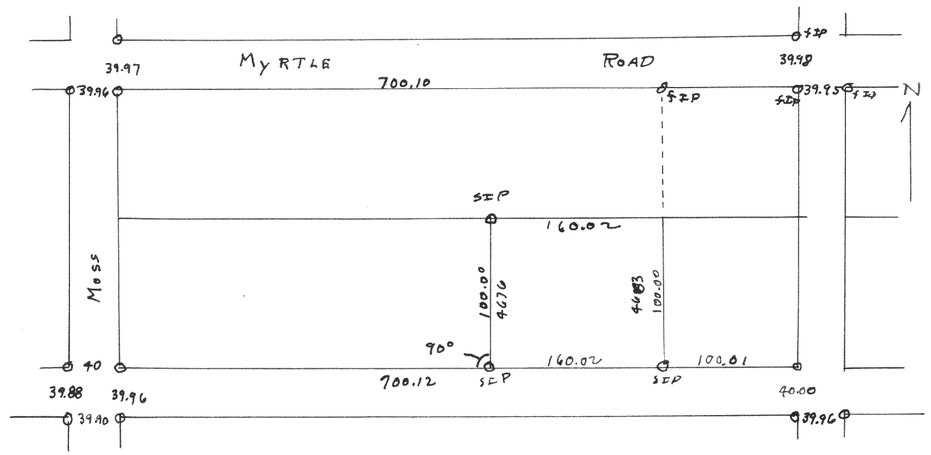

Plat of survey of lots 4676 - 4683 Bell Lake Subdivision T1N R1BE Walworth County

May 7, 1949

Lloyd L Jensen RLS
County Surveyor