

2090

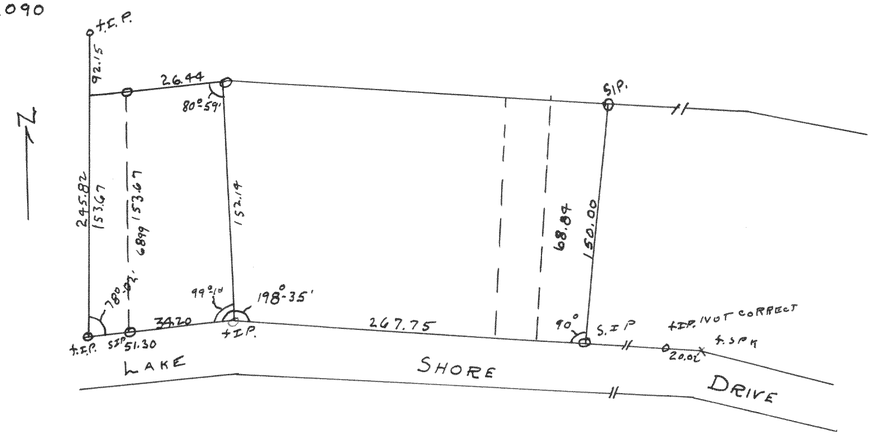

Plat of survey of lots 6884-6899 Bell Lake Subdivision
TINRIBE Walworth County
May 9, 1949

Floyd S Jensen PLS
County Surveyor


2091

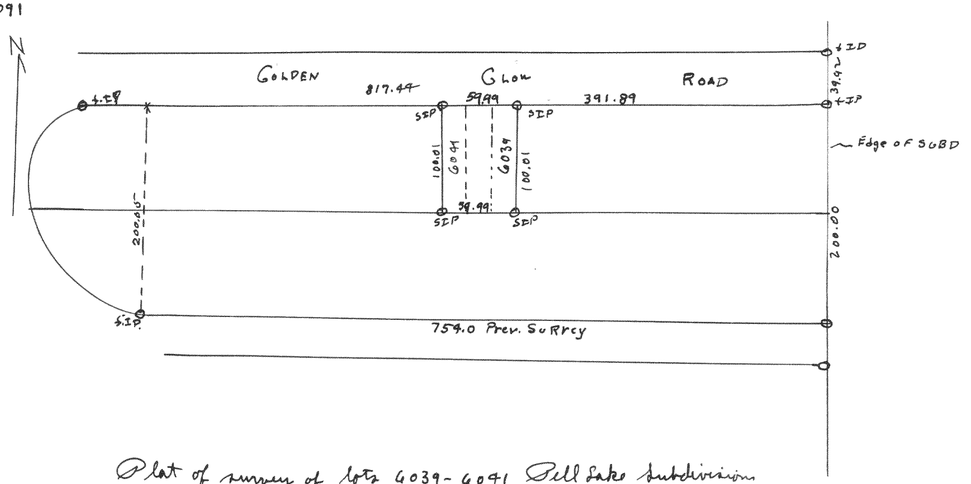

Plat of survey of lots 6039-6041 Bell Lake Subdivision
TINRIBE Walworth County
May 11, 1949

Floyd S Jensen PLS
County Surveyor


2092

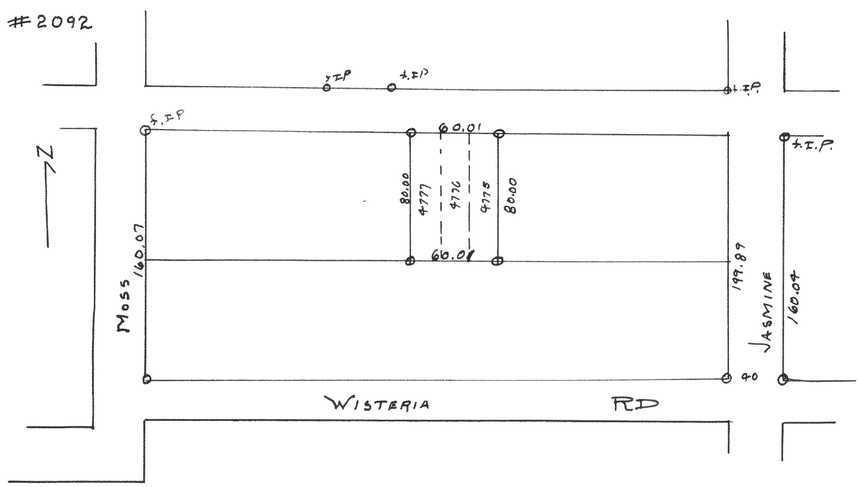

Plat of survey of lots 4775-4777 Bell Lake Subdivision
TINRIBE Walworth County
June 8, 1949

Floyd S Jensen PLS
County Surveyor

2093

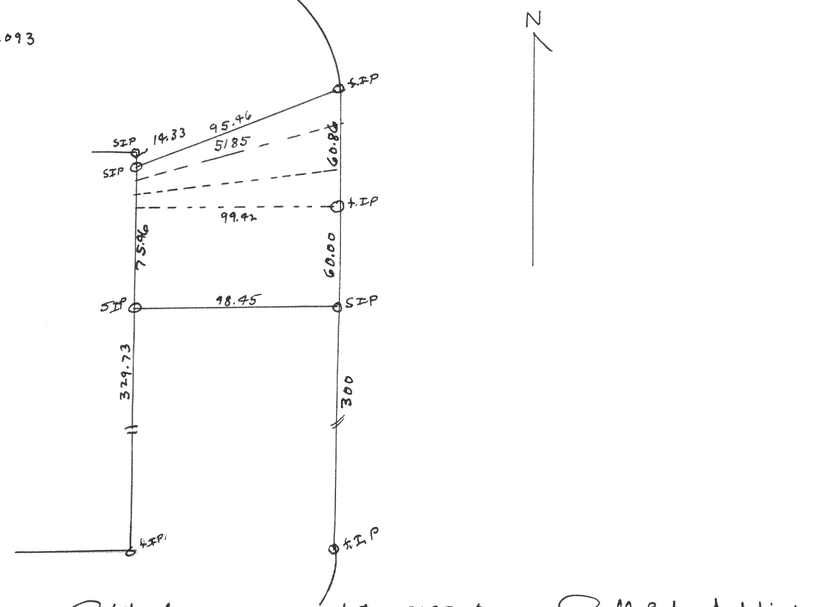

Plat of survey of lots 5185 to 5190 Bell Lake Subdivision
TINRIBE
June 8, 1949

Floyd S Jensen PLS
County Surveyor