

#2094

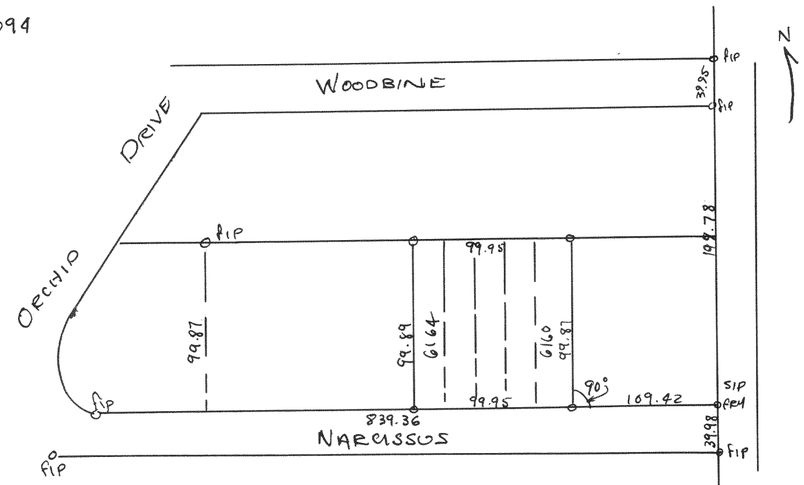

Plat of survey of Lts 6160-6164 Bell Lake Subd.
TINCITE, Walworth Co., Wisconsin
Aug 30, 1949

Floyd L. Jensen
County Surveyor

#2095

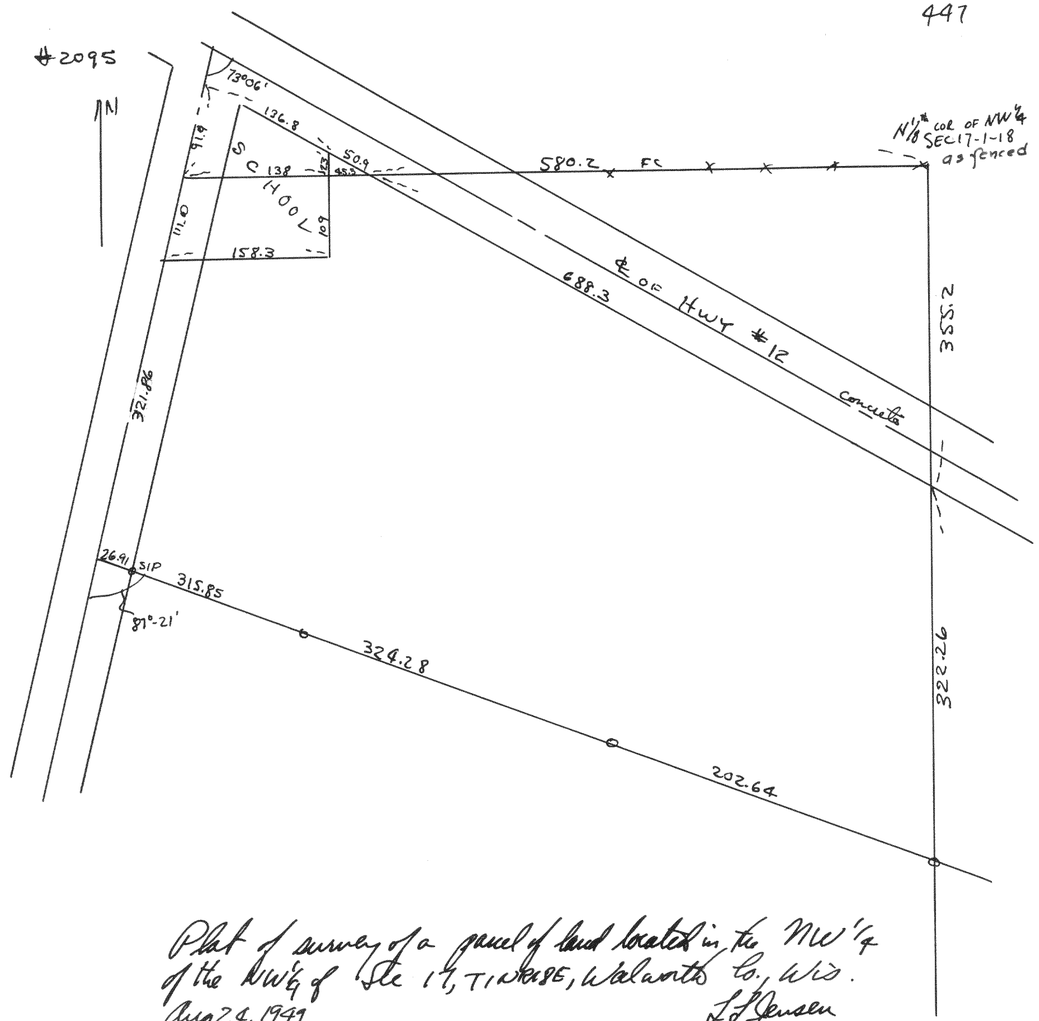

Plat of survey of a parcel of land located in the NW¼
of the NW¼ of Sec 17, T1N R18E, Walworth Co., Wis.
Aug 24, 1949

L.L. Jensen
County Surveyor