
SURVEY NO. 1265

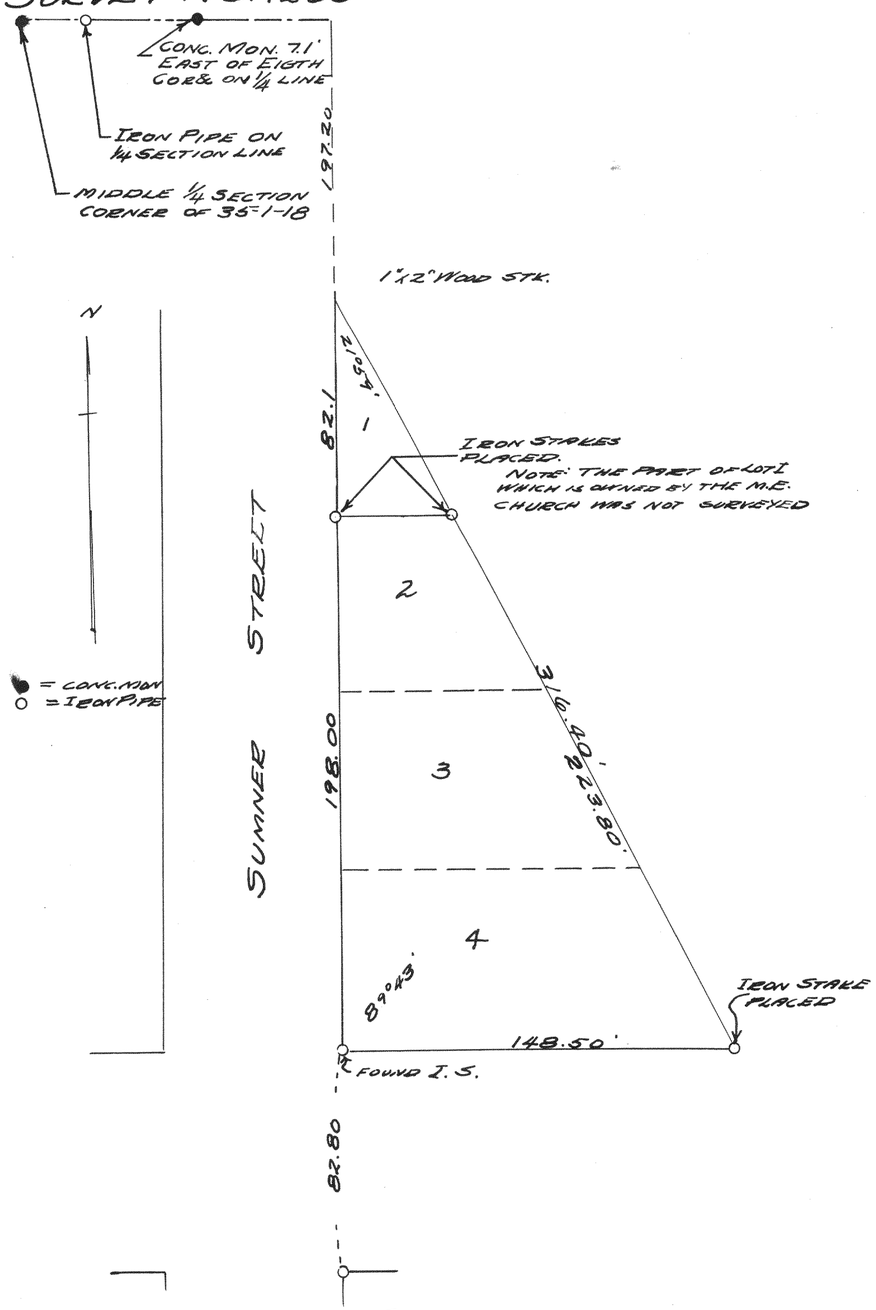


PLAT OF SURVEY OF LOTS 2, 3, & 4 OF BLOCK ONE OF FREEMAN'S 2ND ADD. TO THE VILLAGE OF GENOA

MAY 23, 1941

Lloyd L. Jensen R.E.J.

SURVEY NO. 1266

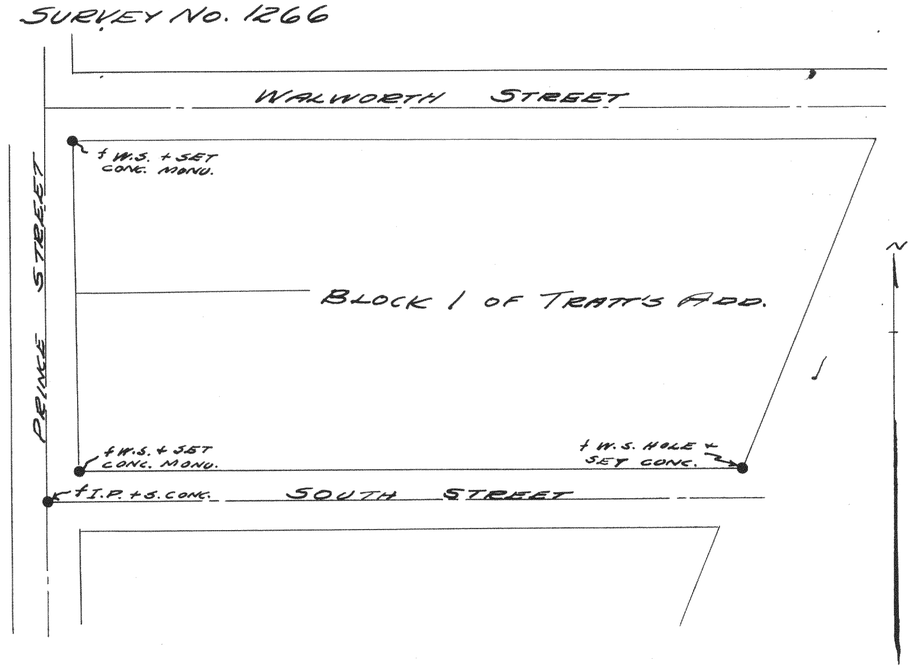

PLAT OF SURVEY TO LOCATE THE BLOCK CORNERS OF BLOCK 1 OF TRATT'S ADDITION TO THE CITY OF WHITEWATER, WALWORTH COUNTY, WISCONSIN.

● = 5"x30" CONC.

DEC., 1941

Lloyd L. Jensen R.E.J.