

#2103

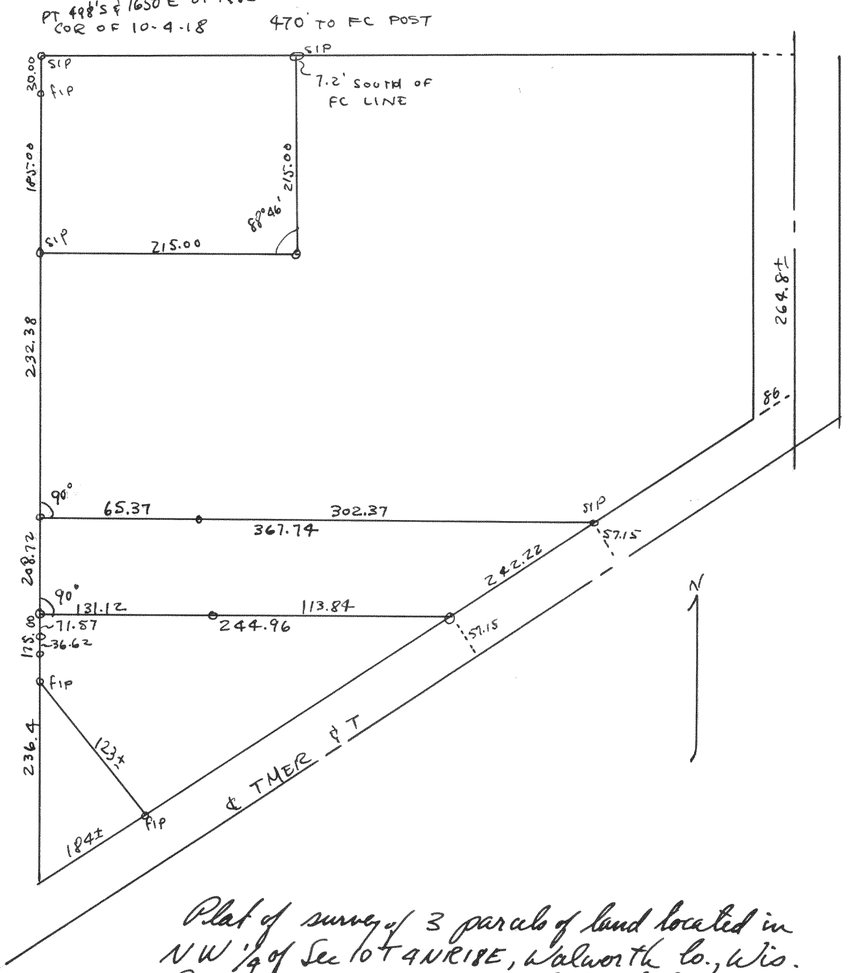

Plat of survey of 3 parcels of land located in NW 1/4 of Sec 10 T4N R18E, Walworth Co., Wis.
June 1, 1949
Lloyd L. Jensen
County Surveyor

#2014

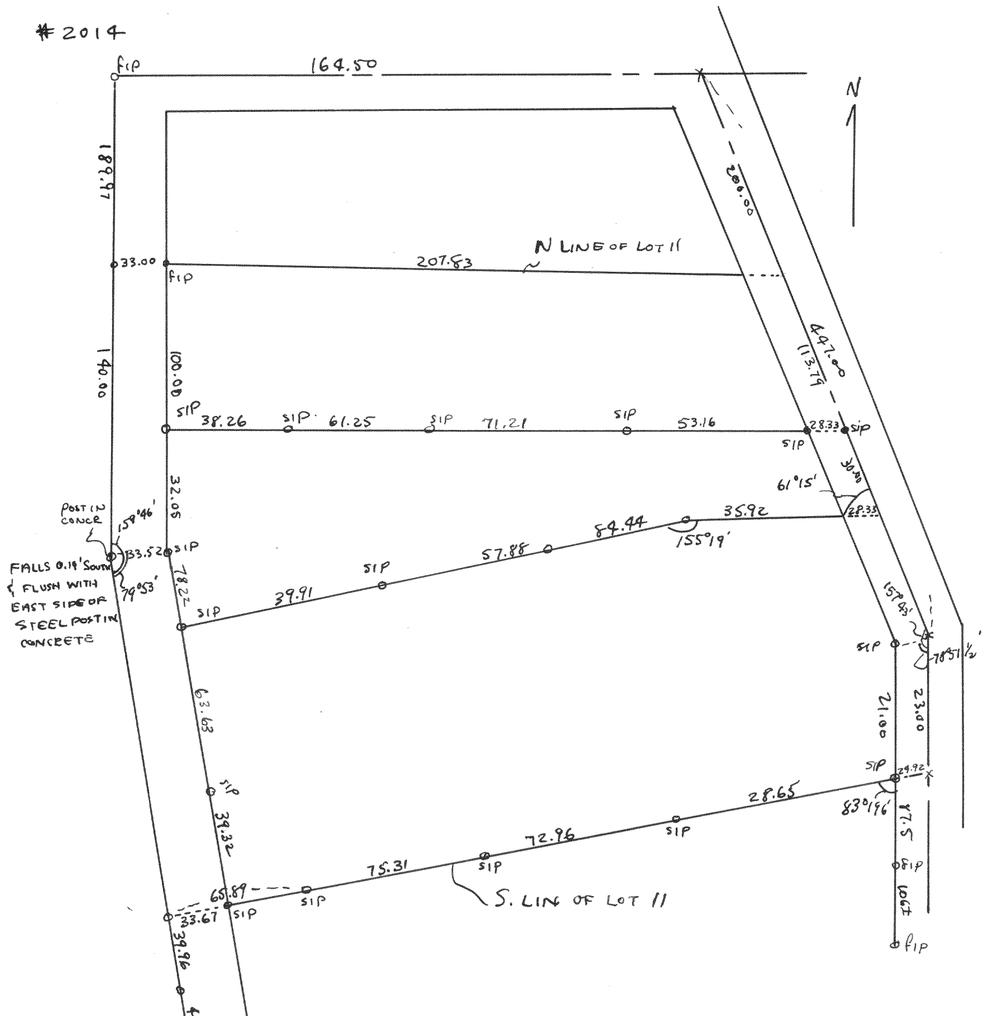

Plat of survey and division of Lot 11 in Beulah Lake Park Subd located in the SW 1/4 Sec 4, T4N R18E, Walworth County, Wis.
July 1949
Lloyd L. Jensen
County Surveyor