#2103

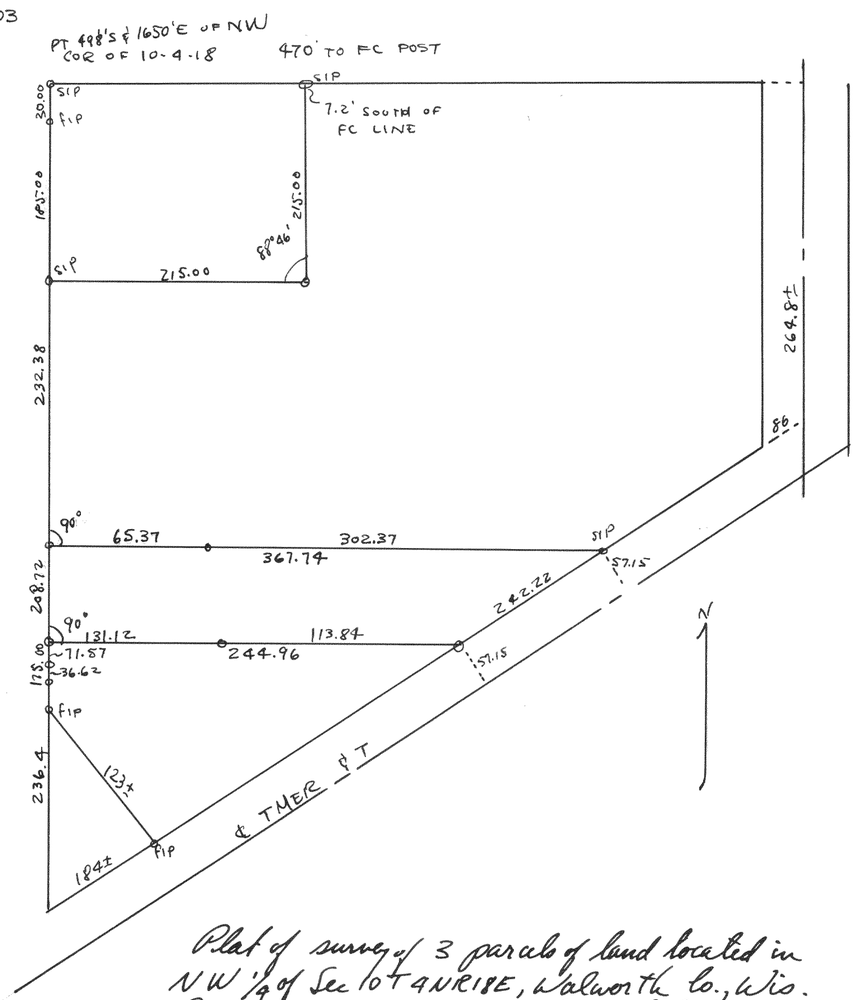

Plat of survey of 3 parcels of land located in NW ¼ of Sec 10 T4NR18E, Walworth Co., Wis.
June 1, 1949

Lloyd J. Jensen
County Surveyor

#2014

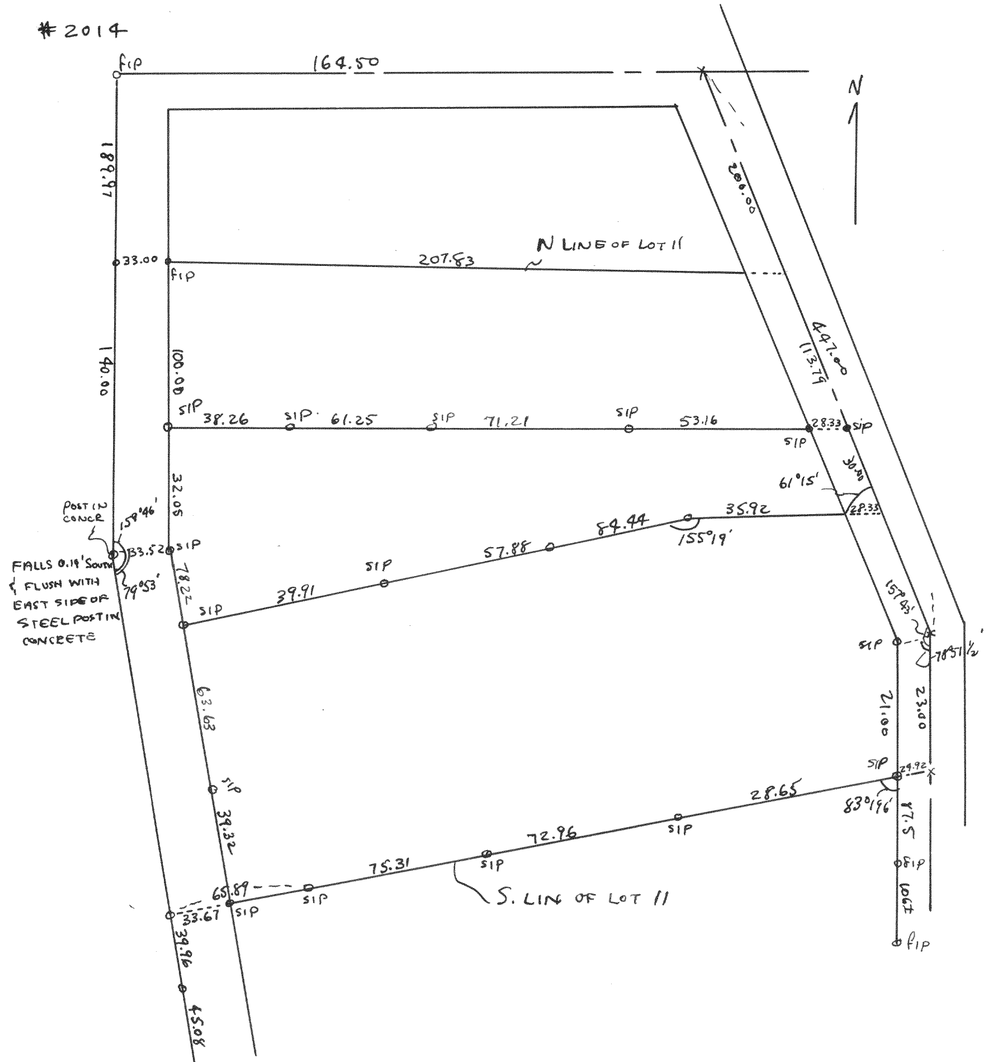

Plat of survey and division of Lot 11 in Beulah Lake Park Suited located in the SW ¼ Sec 4, T4NR18E, Walworth County, Wis.
July 1949

Lloyd J. Jensen
County Surveyor