

2112

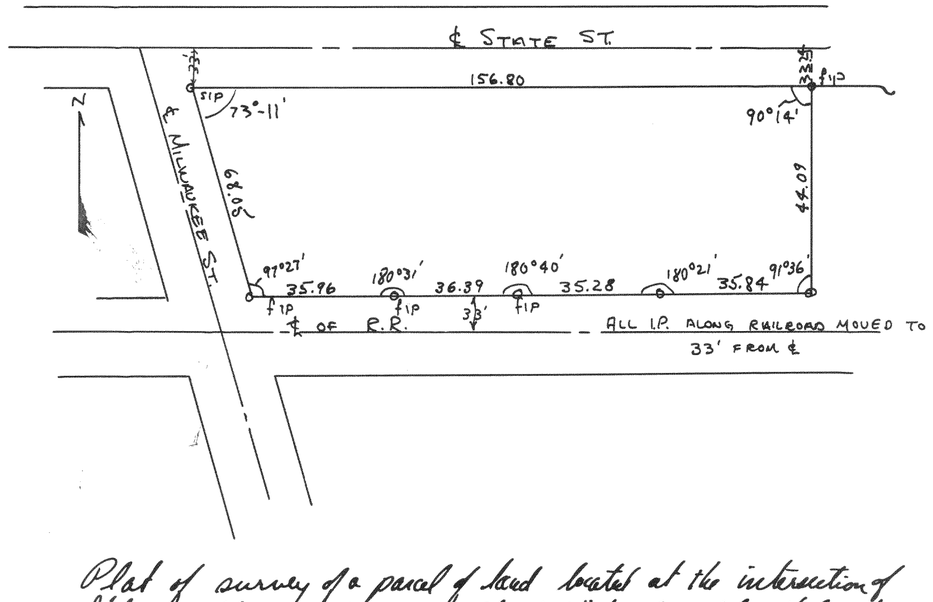

Plat of survey of a parcel of land located at the intersection of State & Milwaukee Sts in the City of Whitewater, Walworth Co., Wis.
May 1949

Lloyd L. Jensen
County Surveyor


#2113

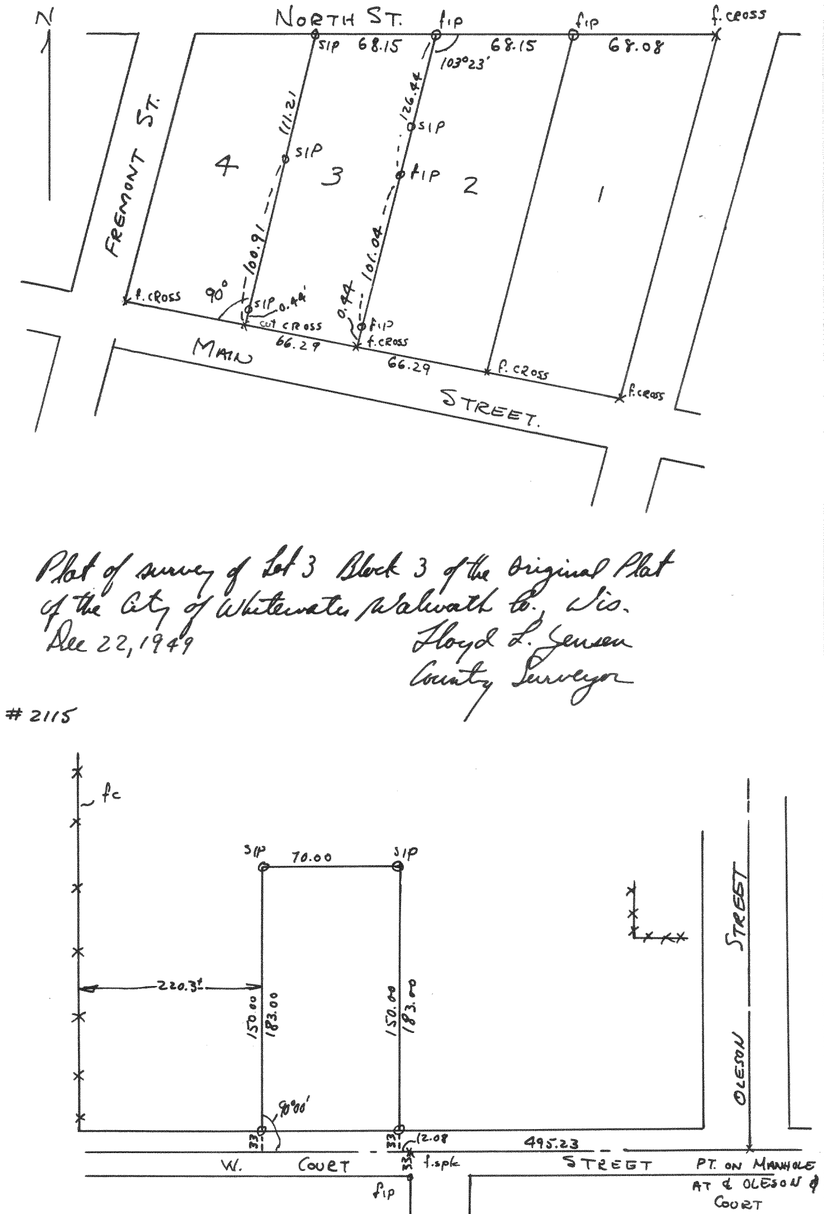

Plat of survey of Lot 3 Block 3 of the Original Plat of the City of Whitewater, Walworth Co., Wis.
Dec 22, 1949

Lloyd L. Jensen
County Surveyor

#2114

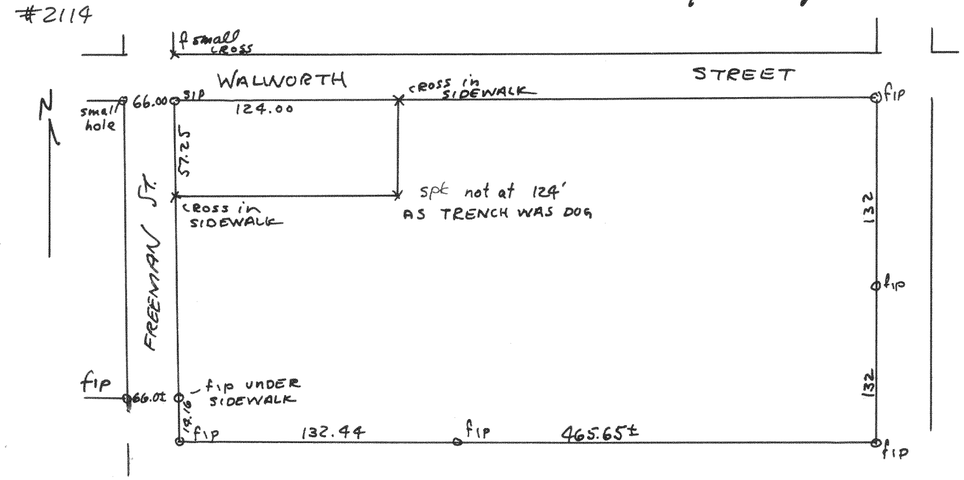

Plat of survey of part of Lot 1 of Original Town located in the Village of Town Caty, Walworth Co., Wis.
July 28, 1949

Lloyd L. Jensen
County Surveyor

#2115

Plat of survey of parcel of land located on W. Court Street in the City of Elkhorn, Walworth Co., Wis.
June 11, 1949

Lloyd L. Jensen
County Surveyor