
458


#2116

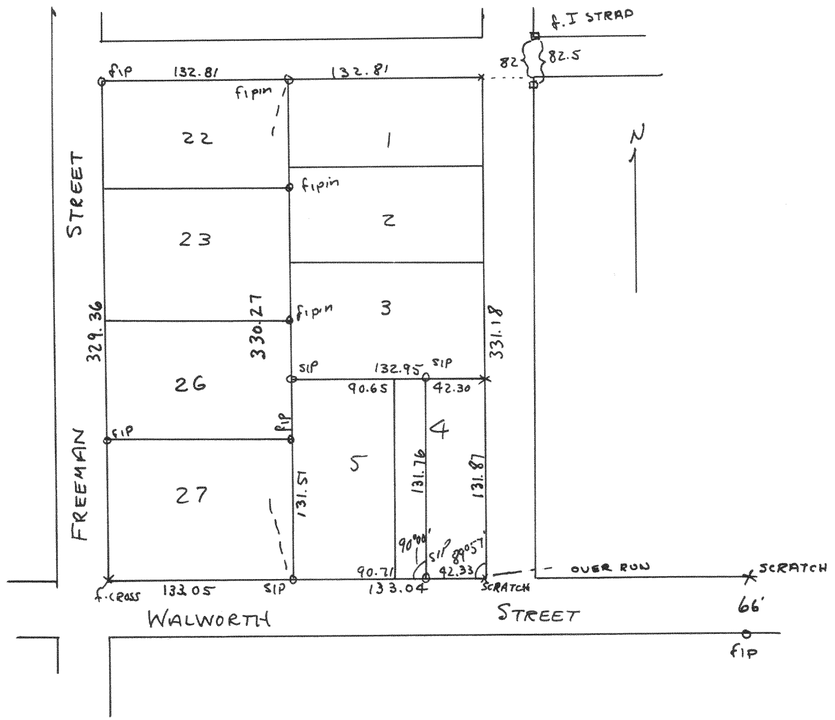

Plat of survey of part of Lots of 4 & 5 of Block 8 of Freeman's 2nd add. to Genoa City, Walworth County, Wis.
1949

Lloyd S. Jensen
County Surveyor

#2117

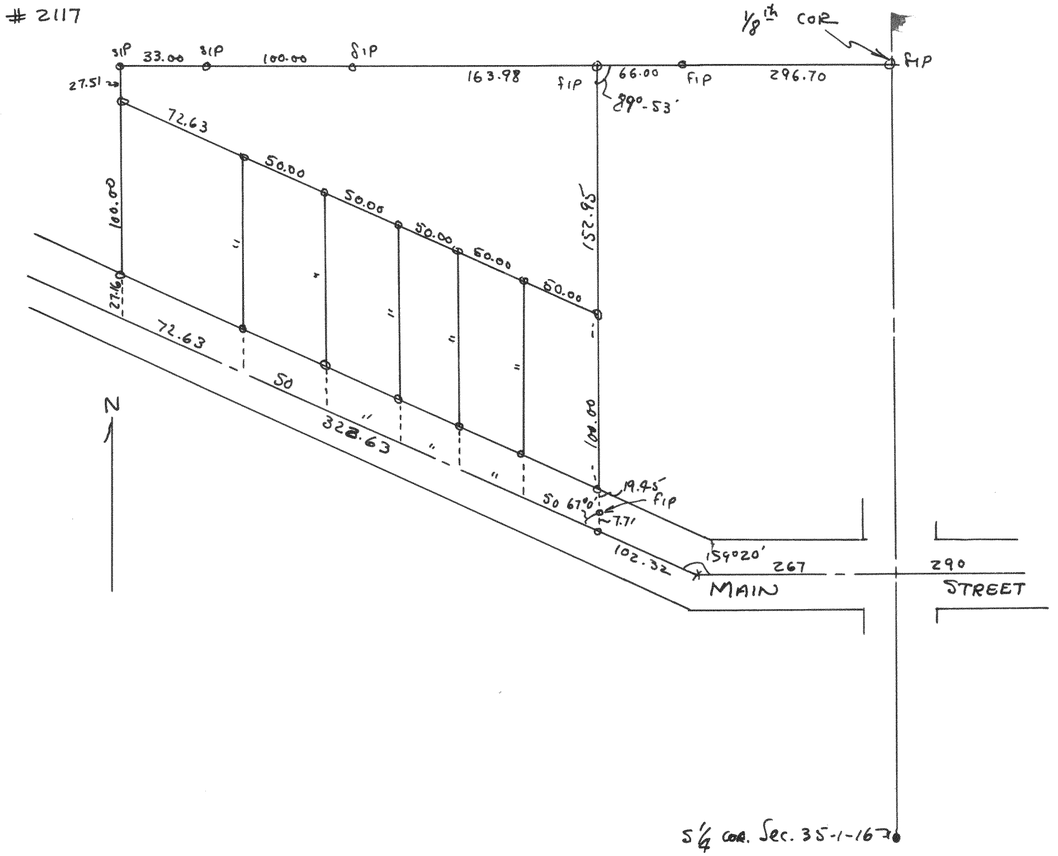

Plat of survey of parcels of land located in the SW 1/4 of Sec 35, T1N R16E in the Village of Genoa City of Walworth Co., Wis.
Jan 4, 1950

Lloyd S. Jensen
County Surveyor