SURVEY NO. 1267

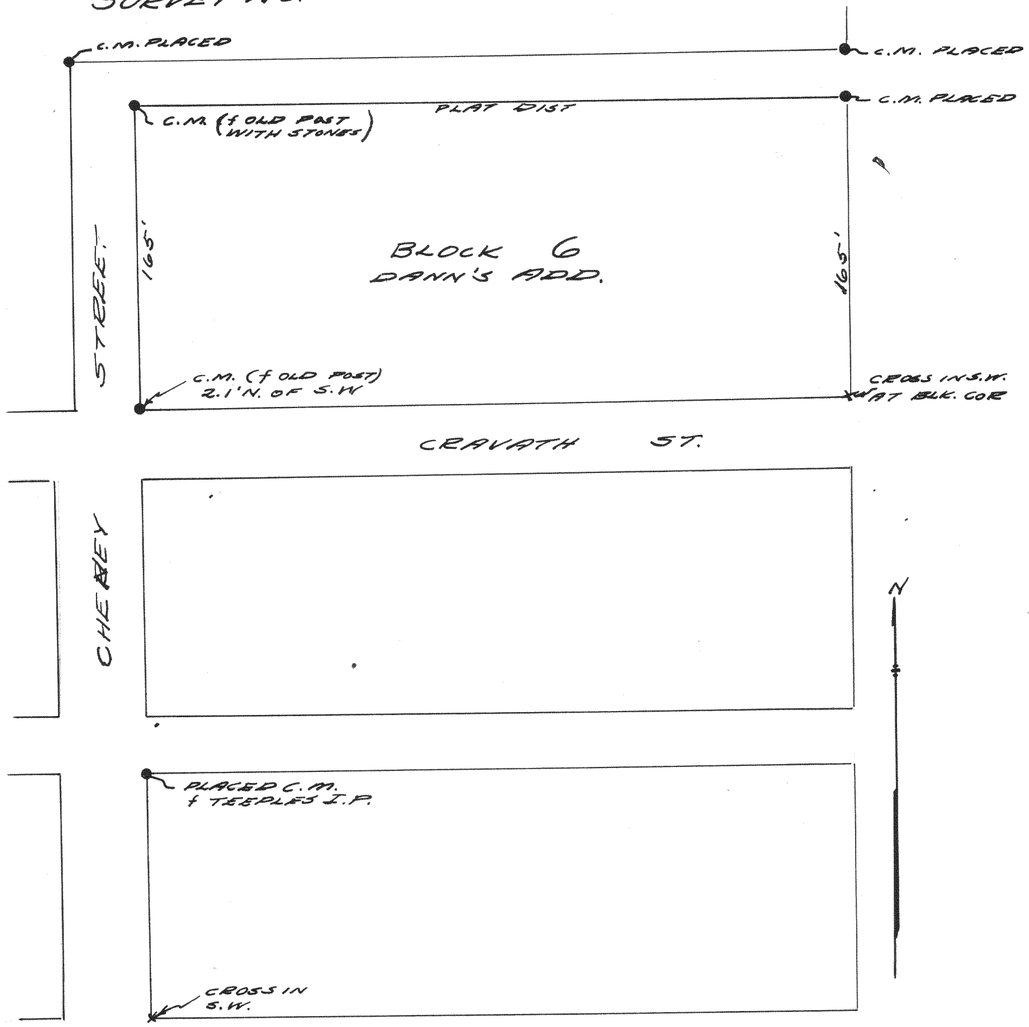

PLAT OF SURVEY TO LOCATE CORNERS OF BLOCK 6 OF DANN'S ADDITION TO THE CITY OF WHITEWATER, WALWORTH COUNTY, WISCONSIN.

SEPT., 1941

Lloyd L. Jensen
R.E.J.

SURVEY NO. 1268

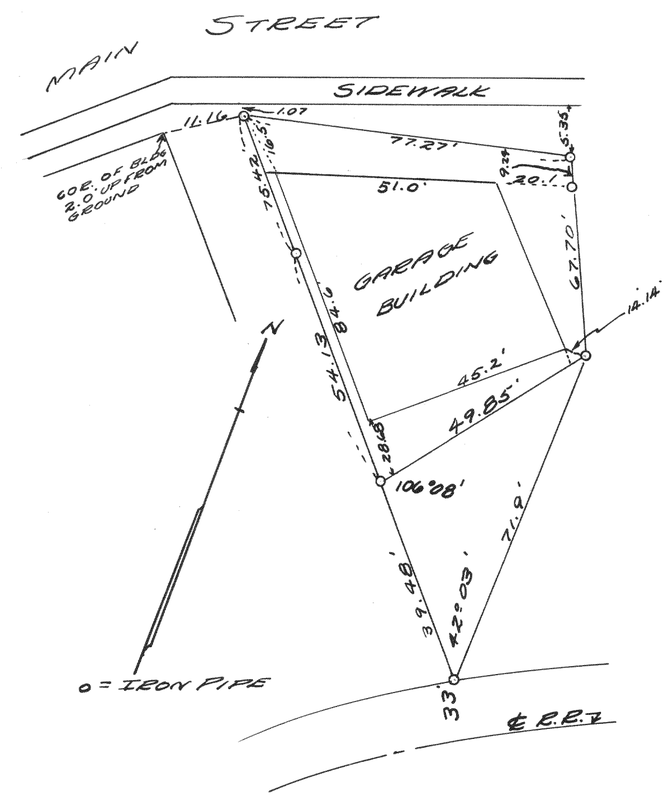

PLAT OF SURVEY OF CUMMINGS GARAGE LOT IN THE CITY OF WHITEWATER, WALWORTH COUNTY, WISCONSIN.

JUNE, 1941

Lloyd L. Jensen
R.E.J.