
460


2120

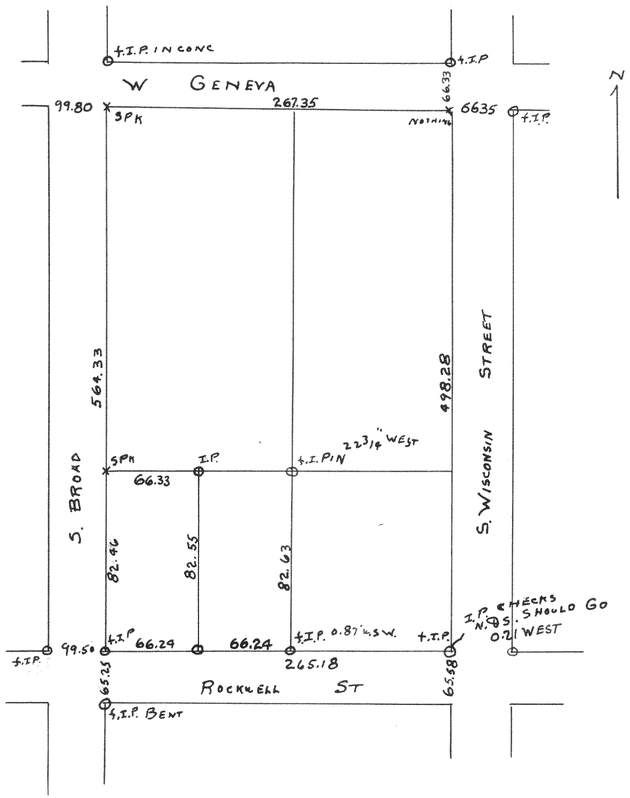

Plat of survey of E 1/2 lot 11 Block 31 in the City of Elkhorn Walworth County
April 13, 1949

Floyd S Jensen
County Surveyor

2121

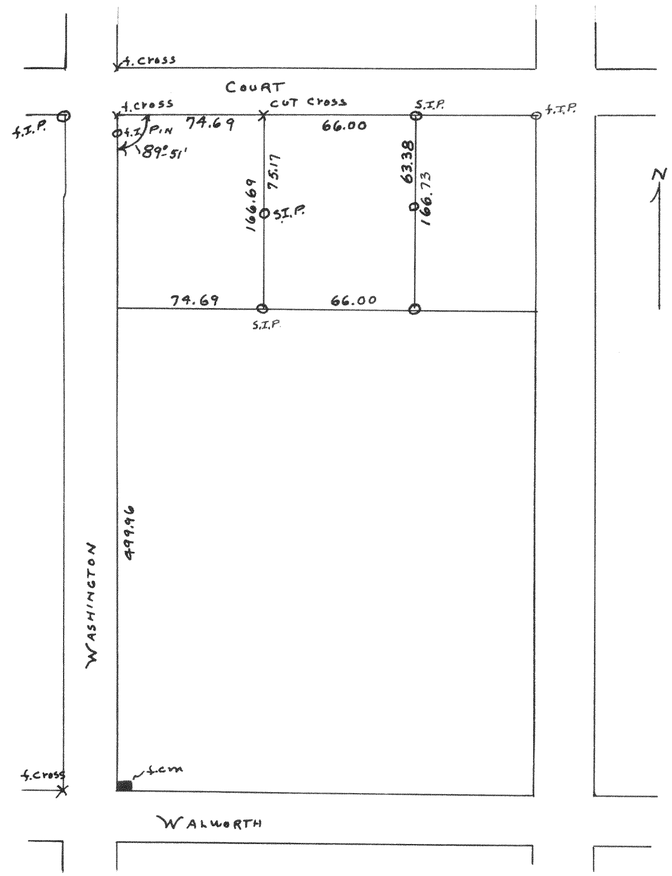

Plat of survey of part of lot 2 Block 21 in the City of Elkhorn Walworth County
June 10, 1949

L L Jensen
County Surveyor