
#2124

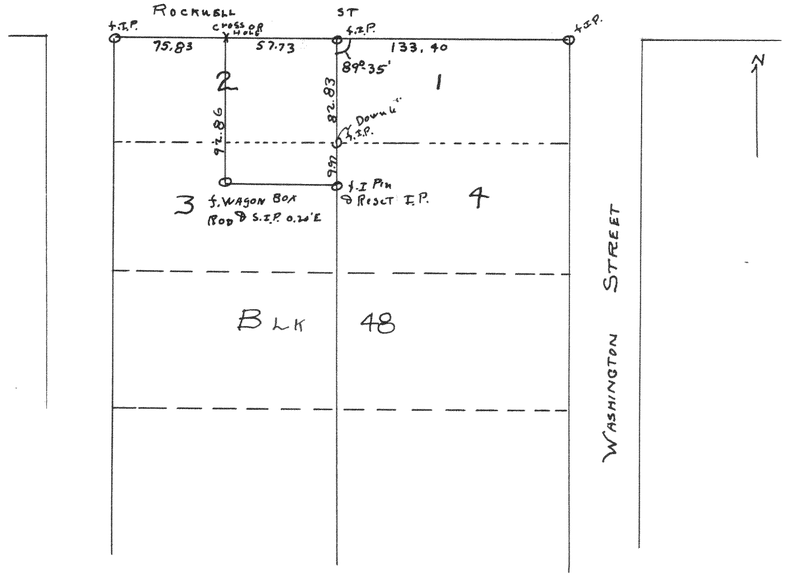


Plat of survey of part of lots 2 & 3 of Blk 48 in Rockwells 2nd addition in City of Elkhorn

Oct 18, 1999

Floyd L Jensen RLS
County Surveyor

#2125

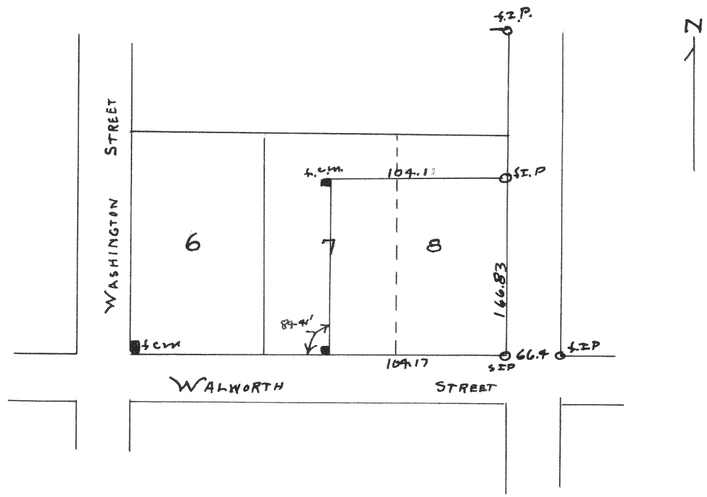


Plat of survey of part of lots 7 and 8 of Block 21 Original Plat in the city of Elkhorn

1999

Floyd L Jensen RLS
County Surveyor

#2126

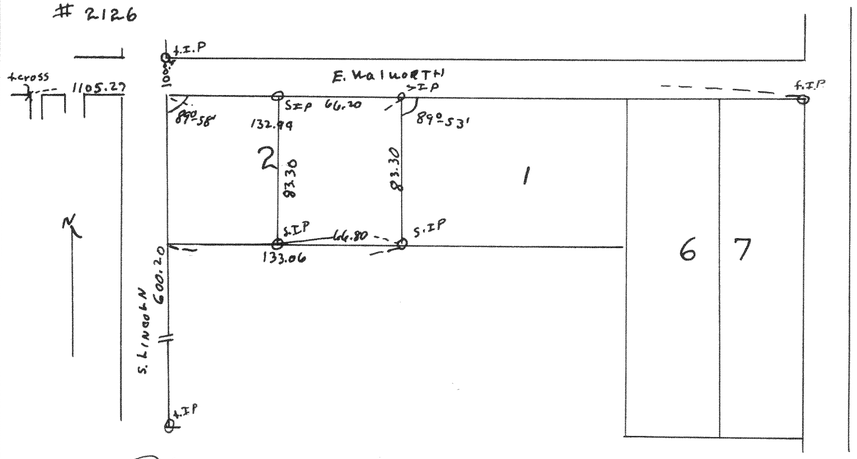


Plat of survey of the eastern part of lot 2 of Block 23 Rockwell's addition - city of Elkhorn, Walworth county

Dec 3, 1999

Floyd L Jensen RLS
County Surveyor

#2127

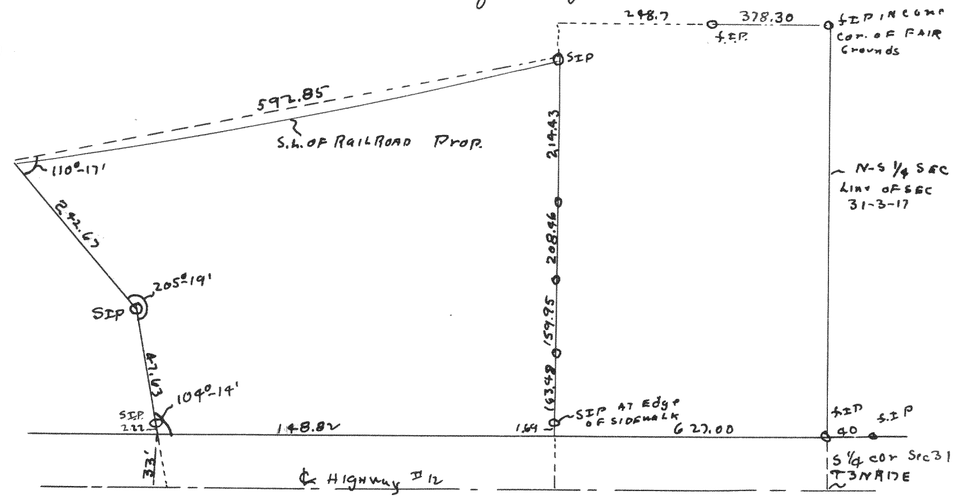

Plat of survey of a parcel of land located in the s w 1/4 of section 31 T3N R17E Walworth County

Dec 9, 1999

Floyd L Jensen RLS
County Surveyor