

#2128

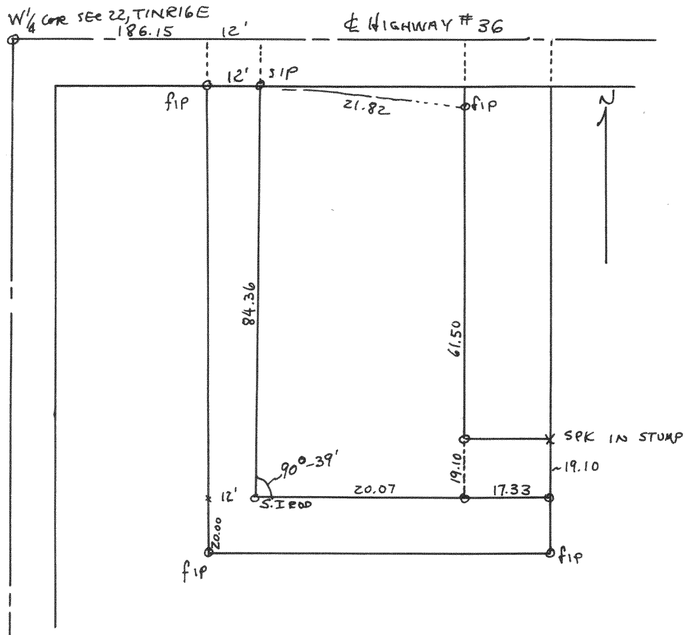

Plat of survey of part of O.L. 201 of the Village of Walworth, Walworth Co., Wis.
February 4, 1949
Lloyd L. Jensen
County Surveyor

#2129

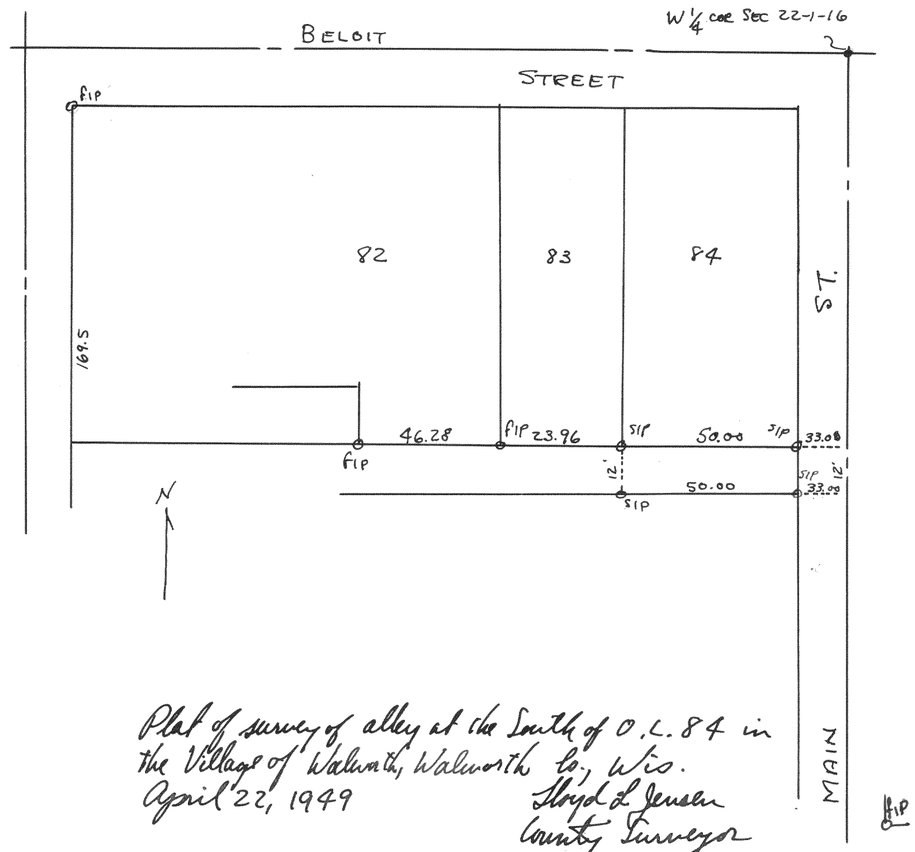

Plat of survey of alley at the South of O.L. 84 in the Village of Walworth, Walworth Co., Wis.
April 22, 1949
Lloyd L. Jensen
County Surveyor