

#2130

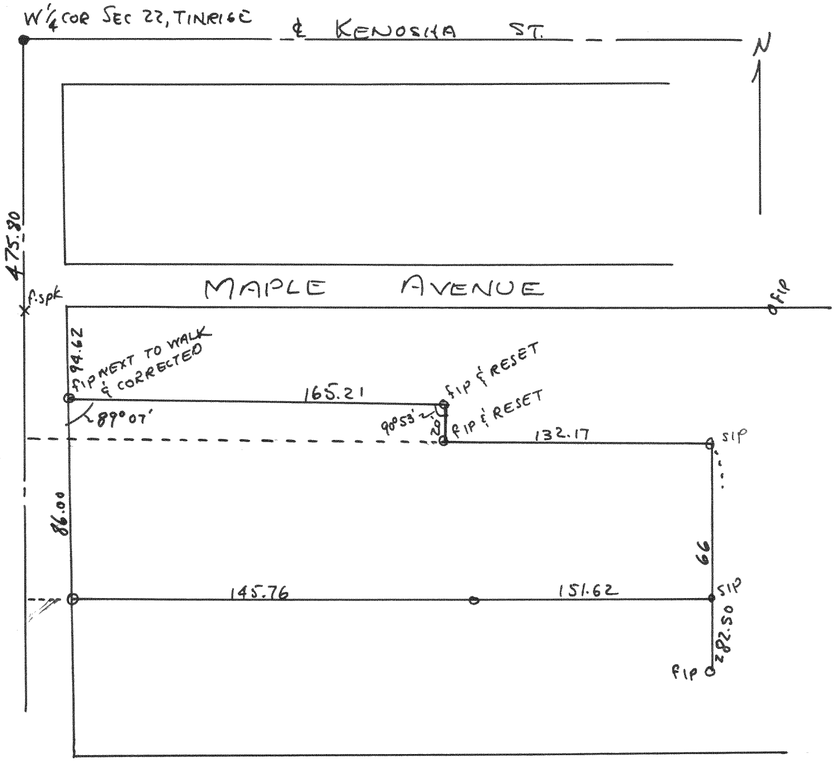

Plat of survey of O.L. 232-233 & part of Lot 34 of Charles Addition, Village of Walworth, Walworth Co., Wis.
Dec 19, 1949

Lloyd L. Jensen
County Surveyor

#2131

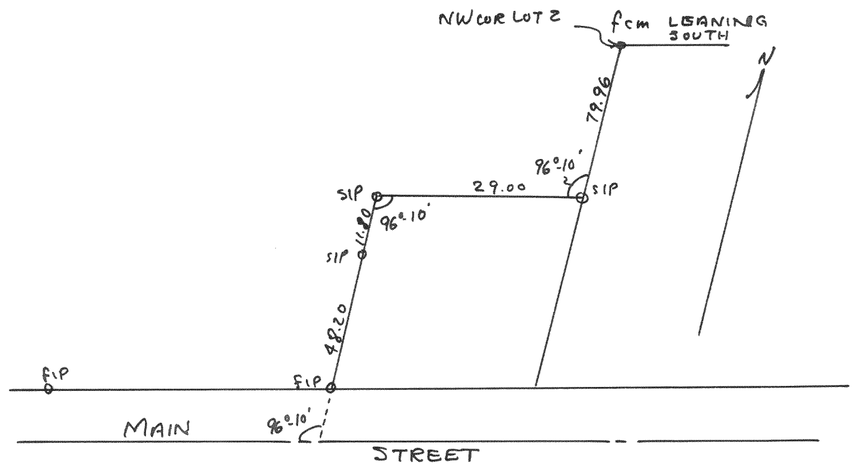

Plat of survey of Lot 3 Blk 1 of C.L. Douglas Addition, Village of Fontana, Walworth Co., Wisconsin
1949

Lloyd L. Jensen
County Surveyor