#2132

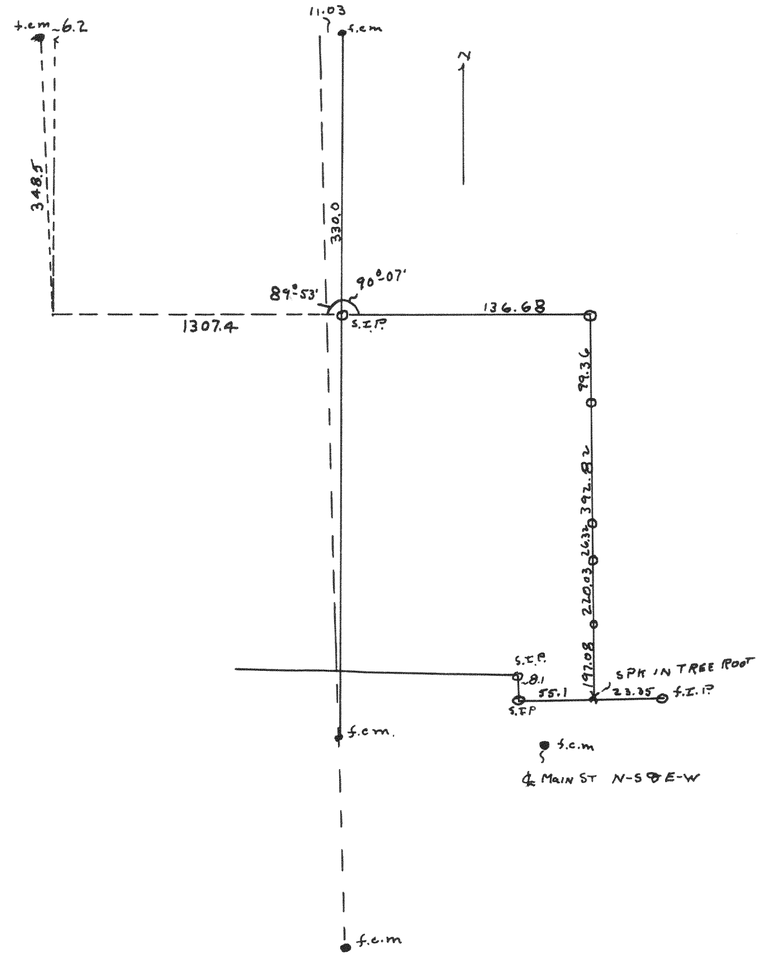

Plat of survey of O.L. 16 in the Village of Fontana, Walworth County

1949

Lloyd L Jensen
County Surveyor

2133

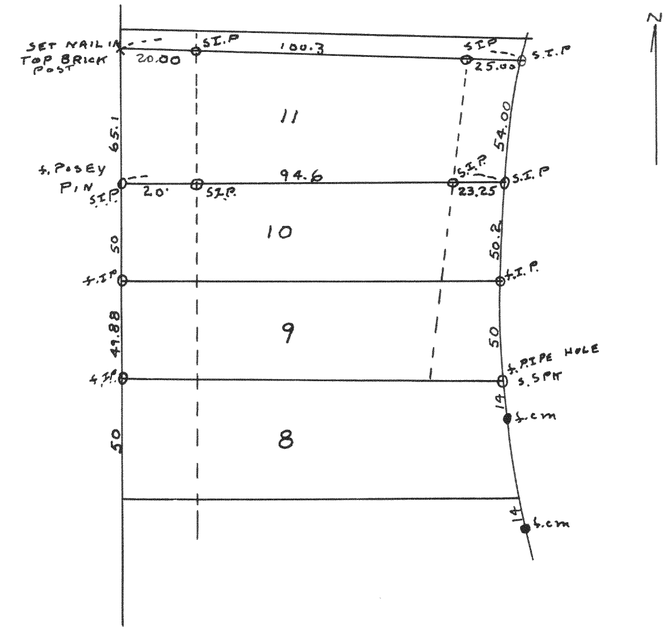

Plat of survey of lot 11 Block 1 Indian Hills Subdivision Village of Fontana. Walworth County.

April 1949

Lloyd L Jensen
County Surveyor