

2134

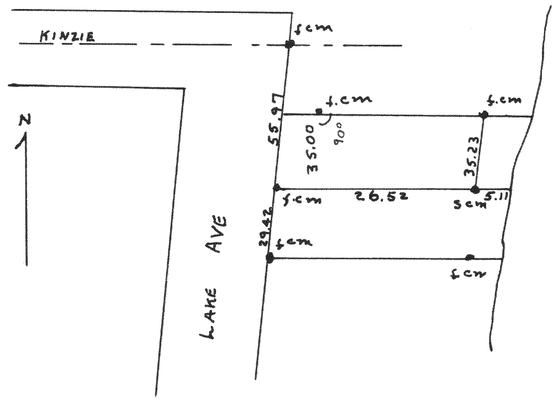

Plat of survey of Lot 1 Block 1 of D.A. Reids Addition
Village of Fontana, Walworth County
June 24, 1949

Lloyd J Jensen
County Surveyor


2135

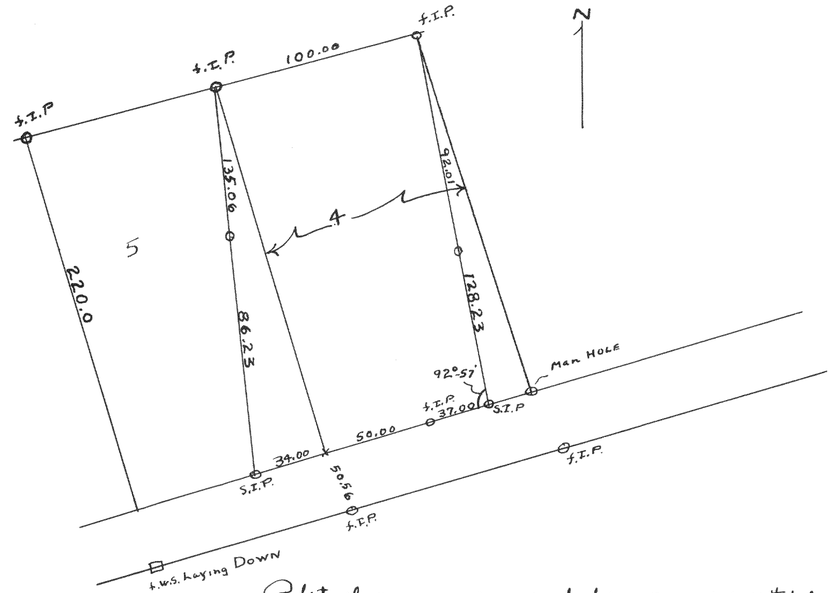

Plat of survey of part of lots 4 & 5 of Unit #1 of
Country Club Estates Village of Fontana, Walworth County
Aug 25, 1949

Lloyd J Jensen
County Surveyor


2136

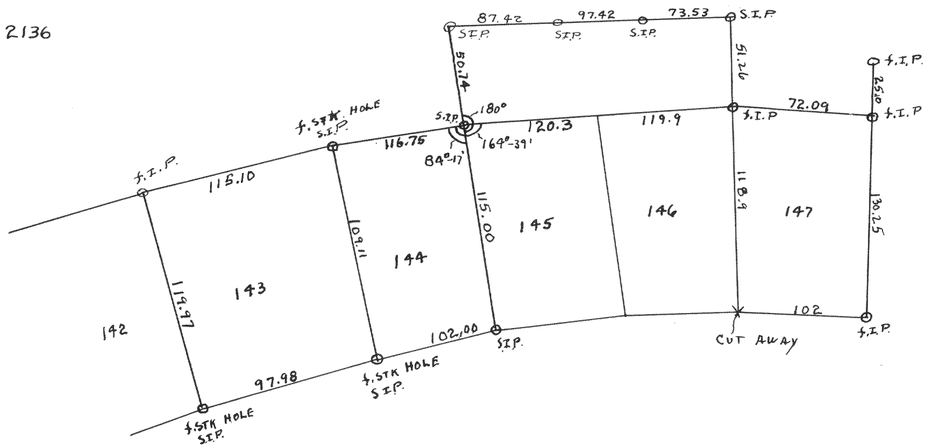

Plat of survey of lot 144 and 145-147 with a 50 foot parcel to rear
of lots 145-146 in Unit #2 of Country Club Estates Village of Fontana
Walworth County
August 1949

Lloyd J Jensen
County Surveyor

2137

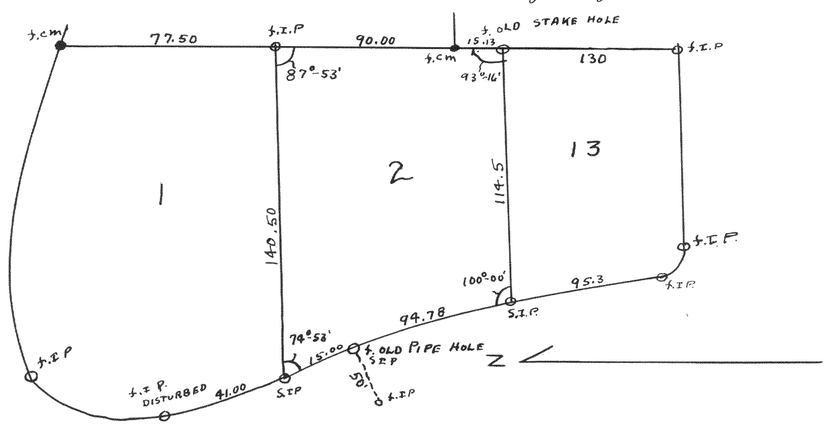

Plat of survey of lot 2 Block F Country Club Estates Unit 3
Village of Fontana, Walworth County
Sept 19, 1949

Lloyd J Jensen
County Surveyor