

#2138

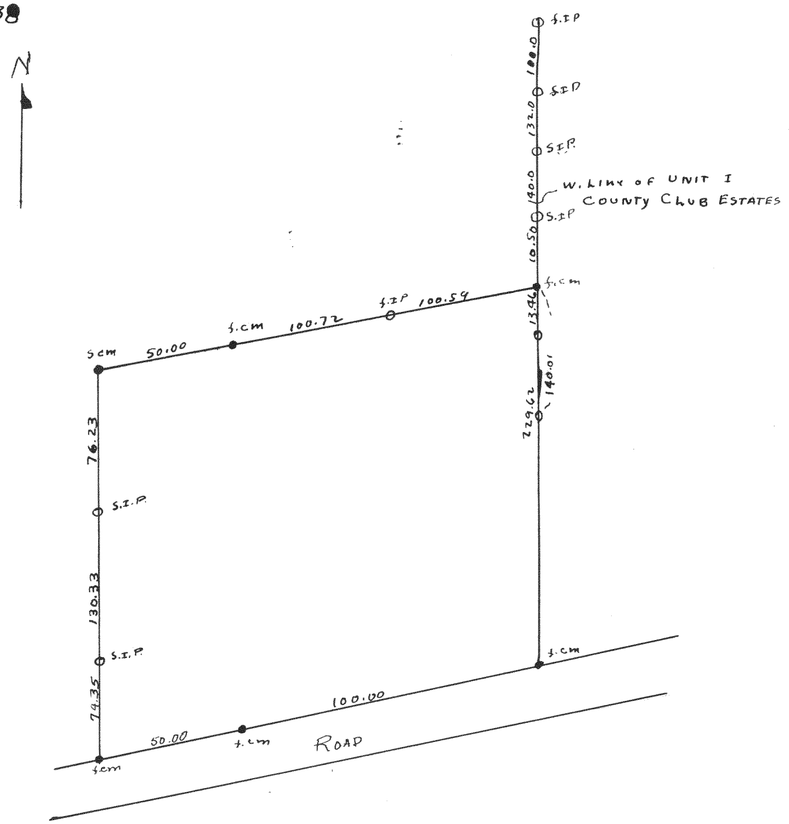

Plat of survey of part of O.L 31 & the West line of Unit I County Club Estates Village of Fontana, Walworth County
Aug 26, 1949

Lloyd S Jensen
County Surveyor

#2139

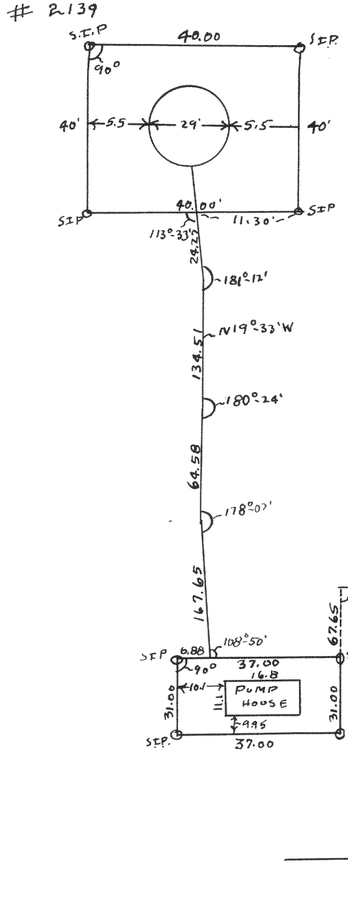

Plat of survey of the Buena Vista Pump House & Reservoir lots located in O.L. 8 Village of Fontana, Walworth County
Sept 16, 1949

Lloyd S Jensen
County Surveyor