

2140

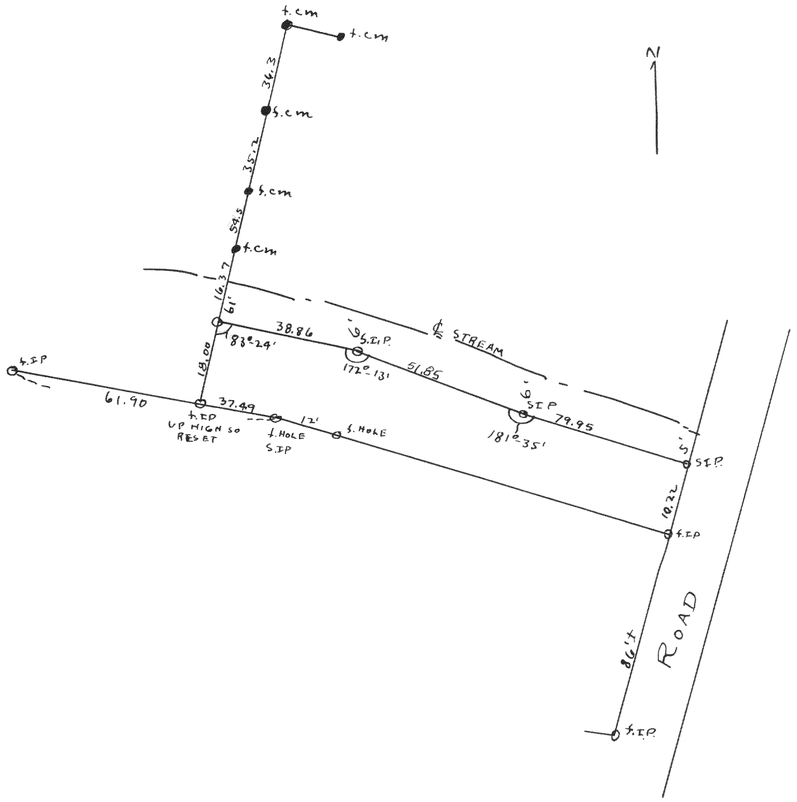

Plat of survey of N. Line of Lot 5 West of the public road in The Gardens, Village of Fontana
Sept 27, 1949

Lloyd I Jensen RLS
County Surveyor

2141

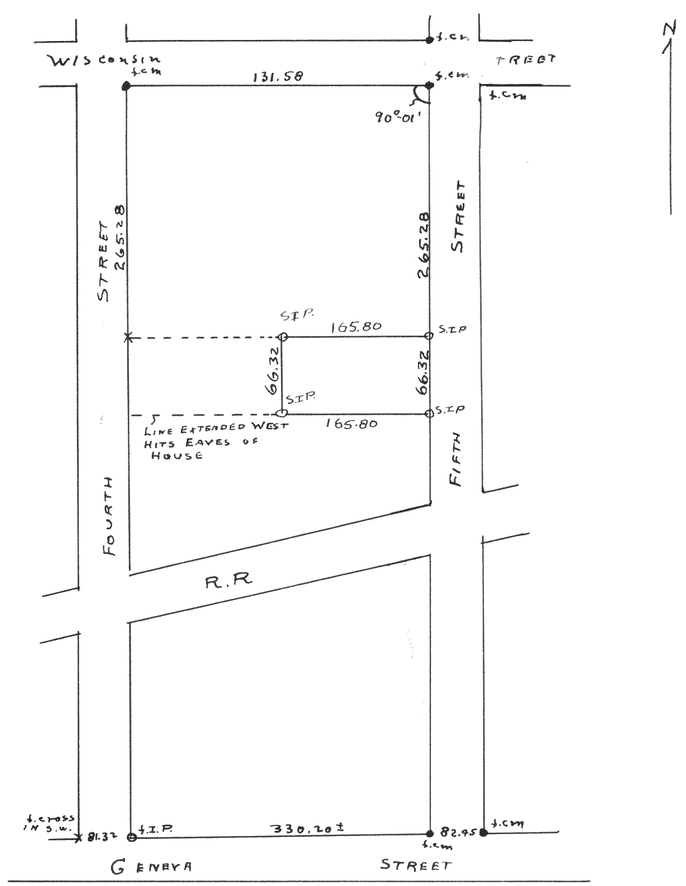

Plat of survey of part of lot 11 Block 3 of Passage Area D Downies Sub-division in the City of Delavan, Walworth County
April 1949

Lloyd I Jensen RLS
County Surveyor