
SURVEY NO. 1269

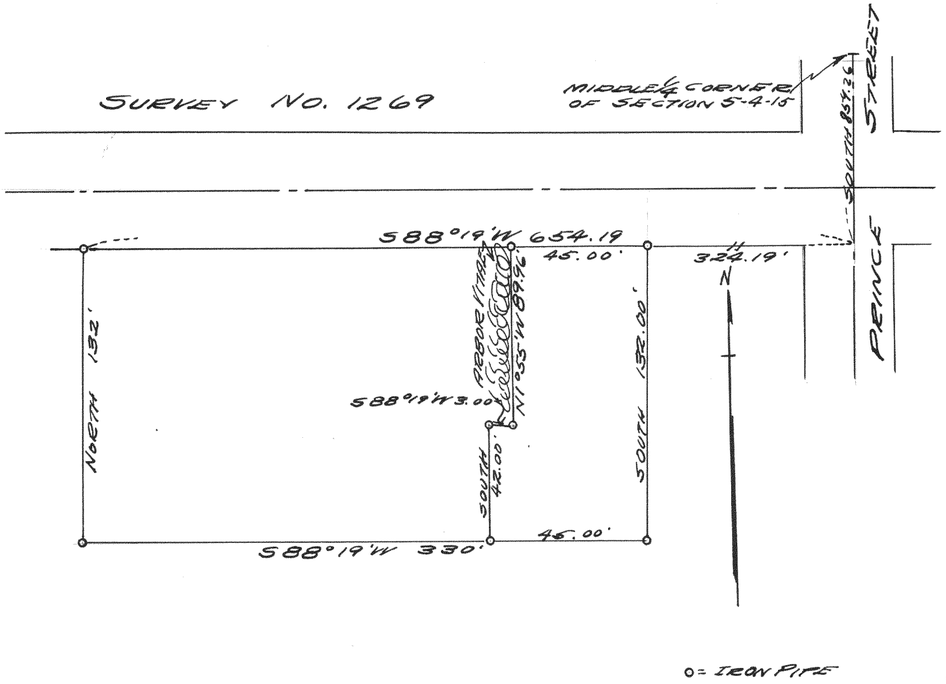


○ = IRON PIPE

PLAT OF SURVEY OF LAND LOCATED IN THE SW¼ OF SECTION 5 T4N, R15E, IN THE CITY OF WHITEWATER, WALWORTH COUNTY, WISCONSIN.

JULY 1, 1941

Lloyd L. Jensen
W.E.J.

SURVEY NO. 1270

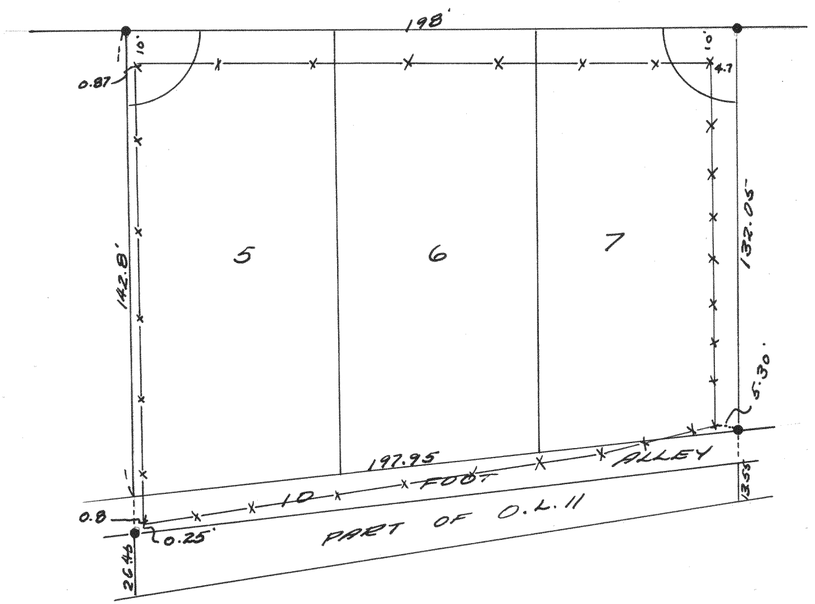

PLAT OF SURVEY OF LOTS 5, 6 & 7 OF BLOCK 3 OF TRIPP & POSEY'S SUBDIVISION OF BLOCK 10 OF TRIPPE'S 2ND ADDITION TO THE CITY OF WHITEWATER, WALWORTH CO., WISCONSIN.

JULY, 1941

Lloyd L. Jensen
W.E.J.