

# 2146

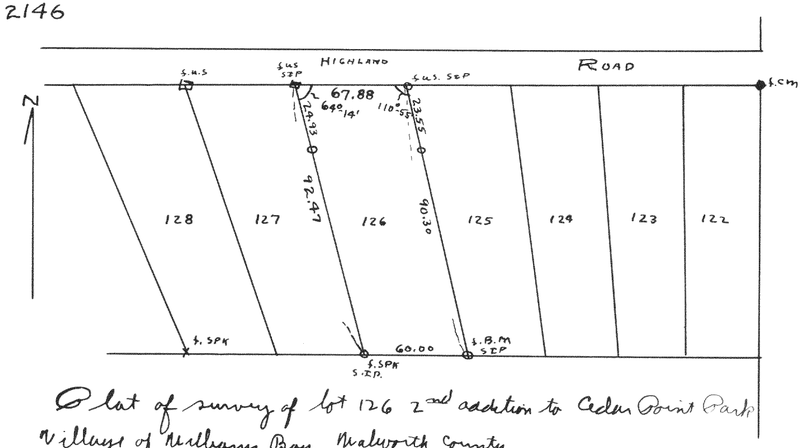


Plat of survey of lot 126 2nd addition to Cedar Point Park
Village of Williams Bay Walworth County
April 1, 1949


Lloyd S Jensen
County Surveyor

# 2147

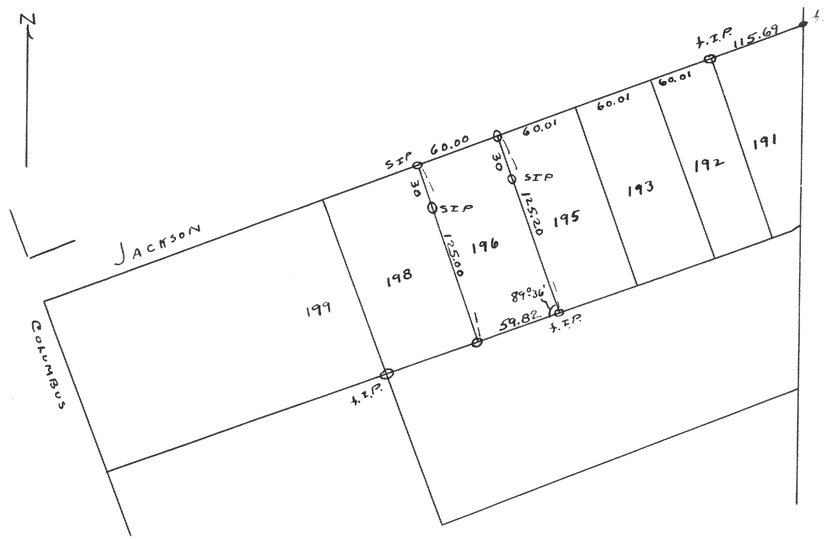


Plat of survey of lot 196 Cedar Point Park Subdivision located
in the Village of Williams Bay Walworth County
April 12, 1949


# 2148

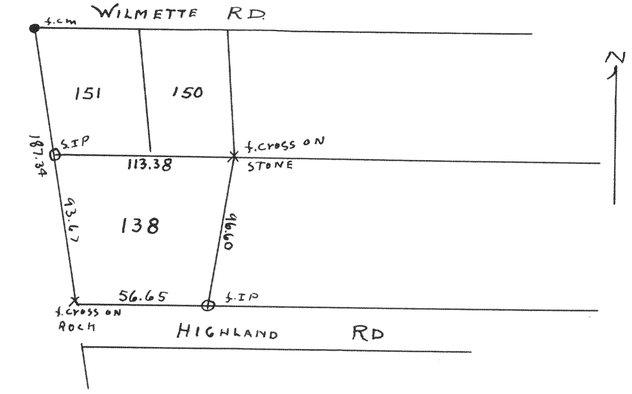


Plat of survey of lot 138 2nd addition of Cedar Point Park
Village of Williams Bay, Walworth County
May 6, 1949

Lloyd S Jensen
County Surveyor

# 2149

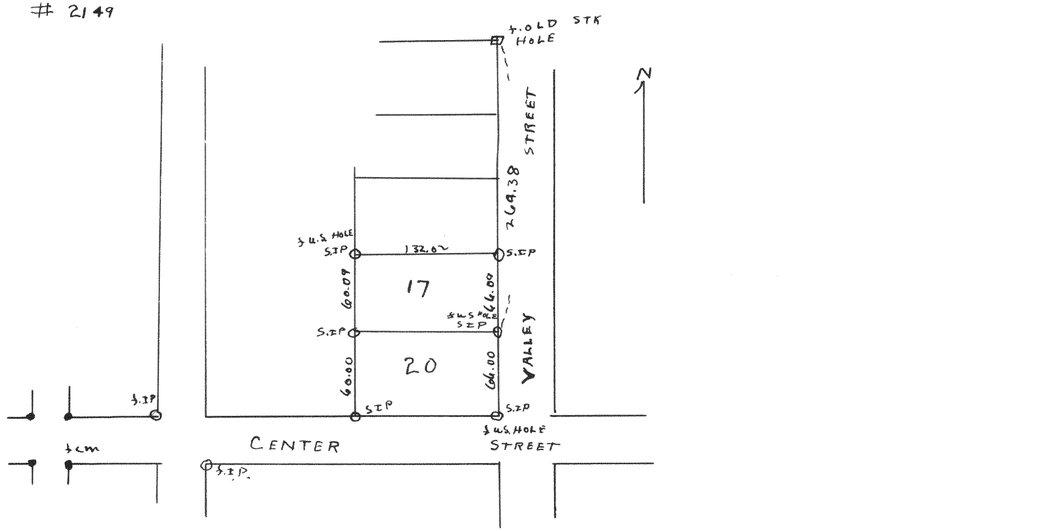


Plat of survey of lots 17 & 20 Block 11 of Williams 2nd Addition - Village of Williams Bay.
May 1949

Lloyd S Jensen
County Surveyor