

2150

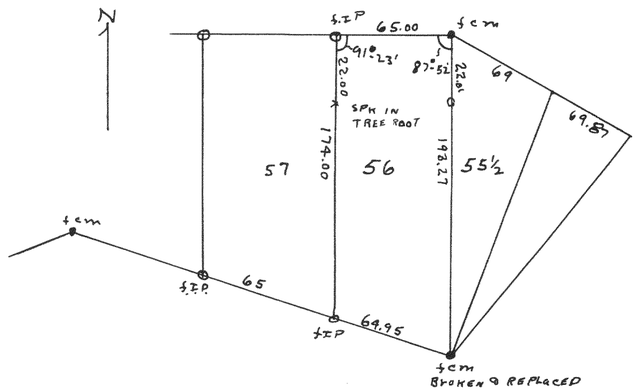

Plat of survey of lot 56 Cedar Point Park 1st addition Village of Williams Bay Walworth county
May 1949

Lloyd S Jensen
County Surveyor


2152

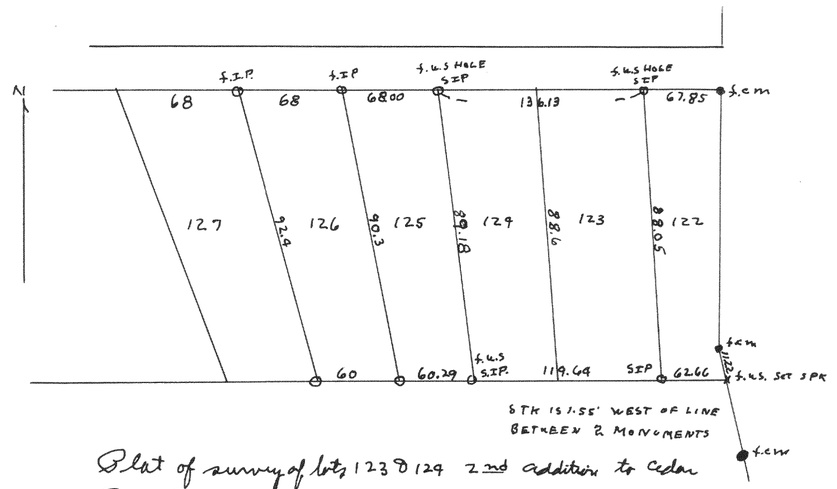

Plat of survey of lots 123 & 124 2nd addition to Cedar Point Park, Village of Williams Bay, Walworth County
May 24 1949

Lloyd S Jensen
County Surveyor


2153

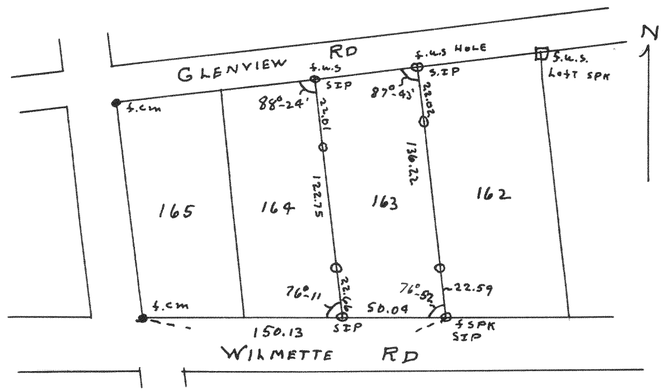

Plat of survey of lot 163 2nd Addition Cedar Point Park Village of Williams Bay Walworth County
May 24, 1949

Lloyd S Jensen
County Surveyor

2154

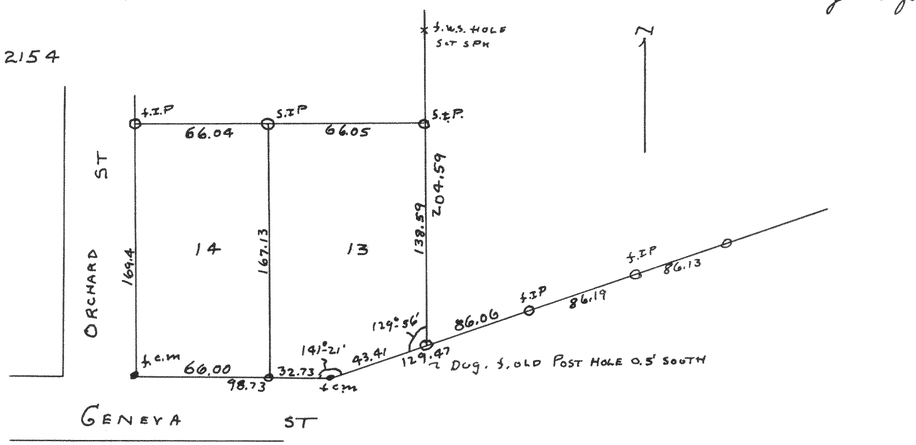

Plat of survey of lots 13 & 14 Block 7, Williams 2nd Addition, Village of Williams Bay, Walworth County
June 8, 1949

Lloyd S Jensen
County Surveyor