

#2159

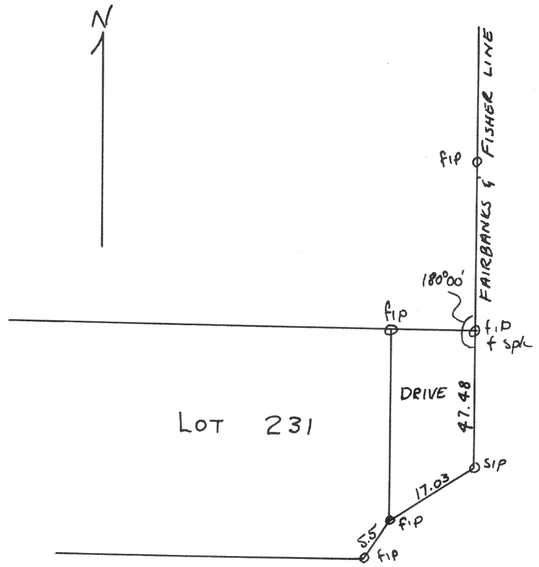


Plat of survey of drive at East end of lot 231 3RD addition to Cedar Pt. Park, Village of Wm Bay, Walworth Co., Wis.
1949
Lloyd L. Jensen
County Surveyor

#2160

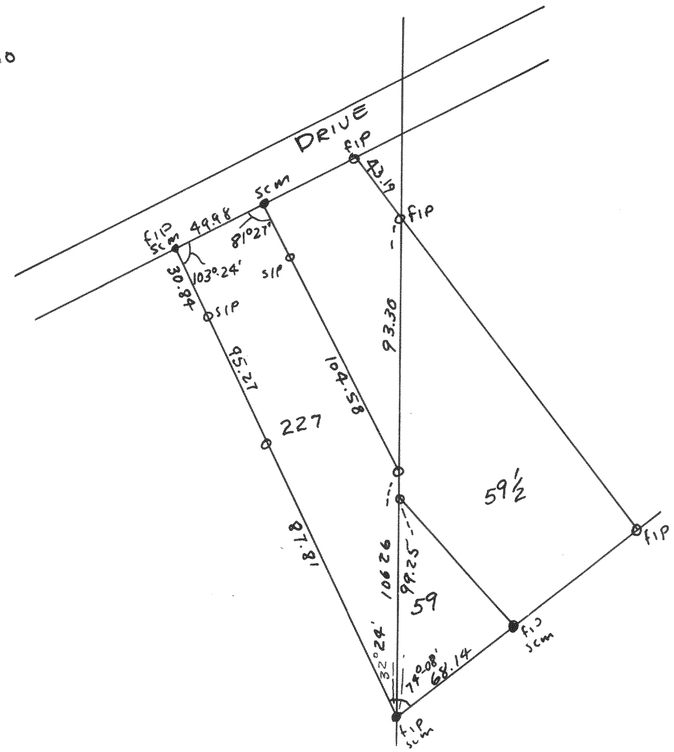


Plat of survey of Lot 227, 3RD Add to Cedar Pt. Park and Lot 59 Orig. Cedar Pt. Park, Village of Wm Bay, Wis.
Aug 1949
Lloyd L. Jensen
County Surveyor

#2161

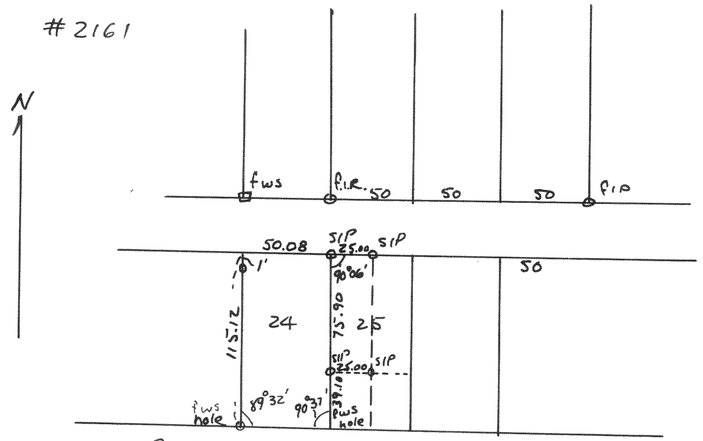

Plat of survey of Lot 24 & W½ of the W⅔ of Lot 25 Sch Vista #1, Vil of Wm Bay, Wal. Co. Wis.
Aug 15, 1949
Lloyd L. Jensen
County Surveyor

#2162

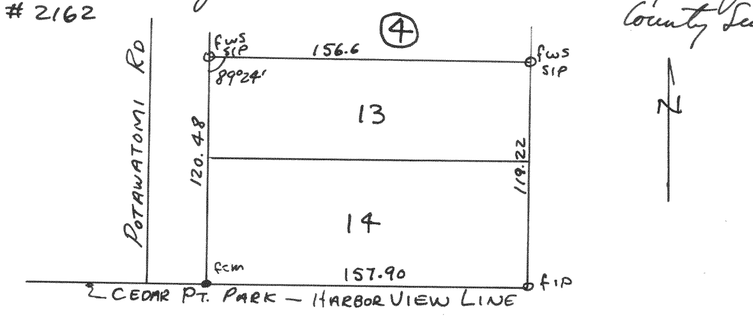

Plat of survey of Lots 13 & 14 Block 4 of Harbor View Subd.
Village of Wm Bay, Wis.
Aug 20, 1949
Lloyd L. Jensen
County Surveyor