

# 2167

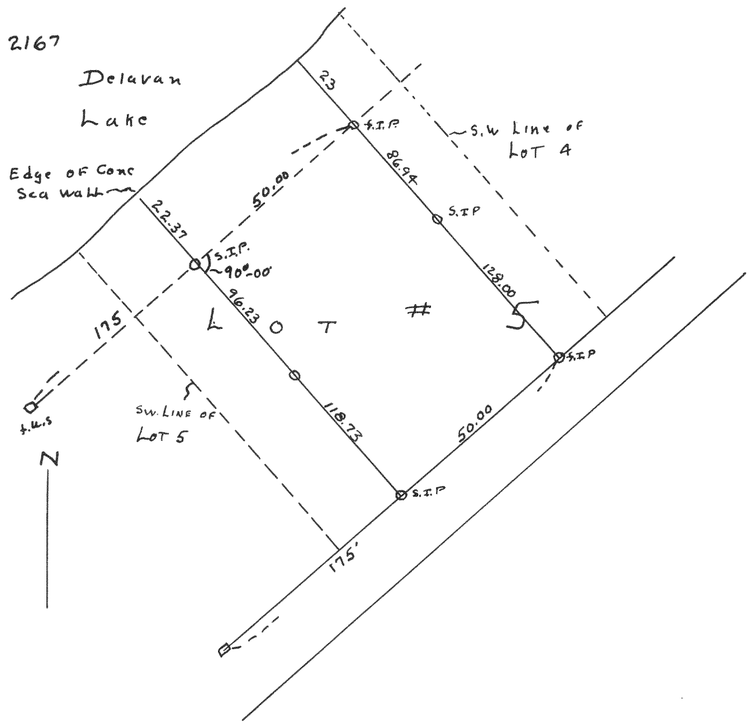


Plat of survey of part of lot 5 of Harrington Subdivision located in section 27 T 2N R 16E Walworth Co
July 25, 1949
Lloyd L Jensen
County Surveyor

# 2168

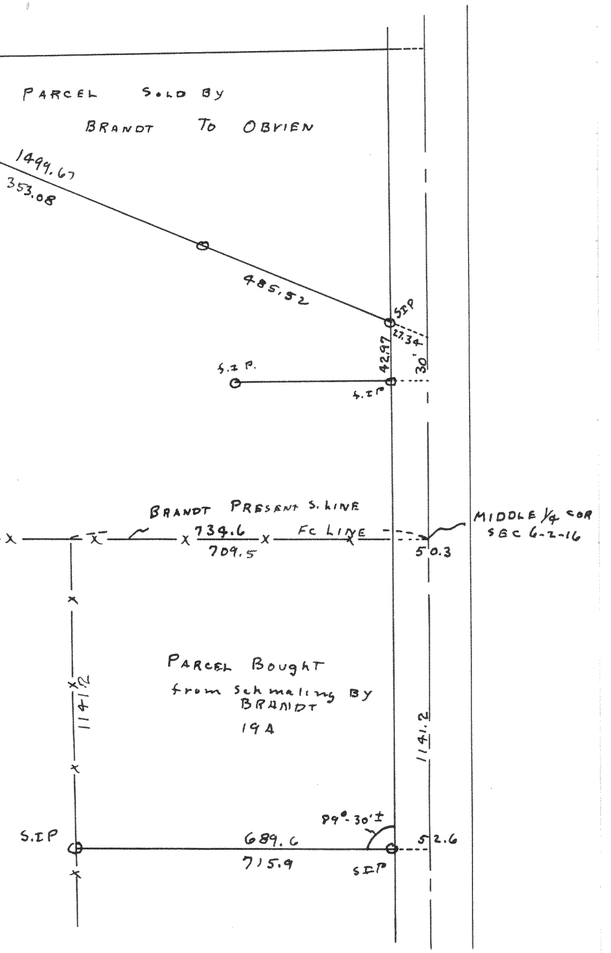


Plat of survey of parcel of land located in section 6 T 2N R 16 E
Walworth County
Aug 29, 1949
Lloyd L Jensen
County Surveyor