
476


2169

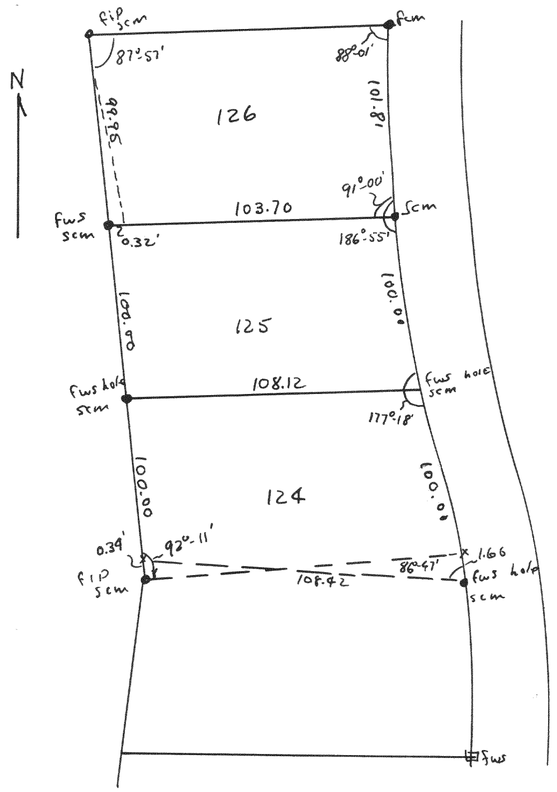

Plat of survey of Lots 124, 125, 126 Country Aire Estates Unit 2, Village of Fontana, Walworth County, Wis.
April 23, 1949

Lloyd L. Jensen
County Surveyor

2170

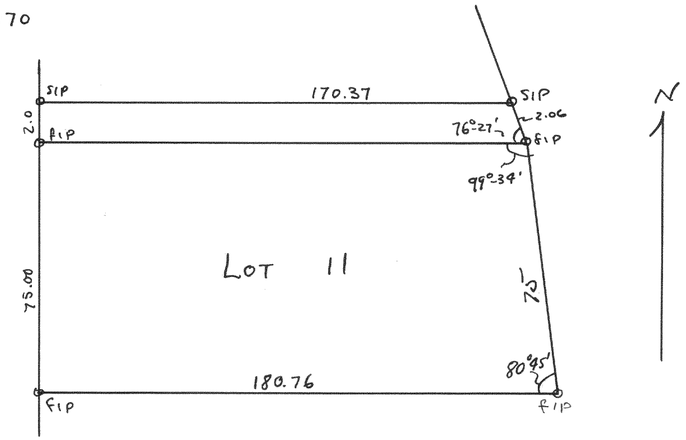

Plat of survey of Lot 11, & the South 2 feet of Lot 12 Block C of Woodlake Subd. located in Sec 9, T1N R17E, Walworth County Wis.
Sept 15, 1949

Lloyd L. Jensen
County Surveyor