

#2180

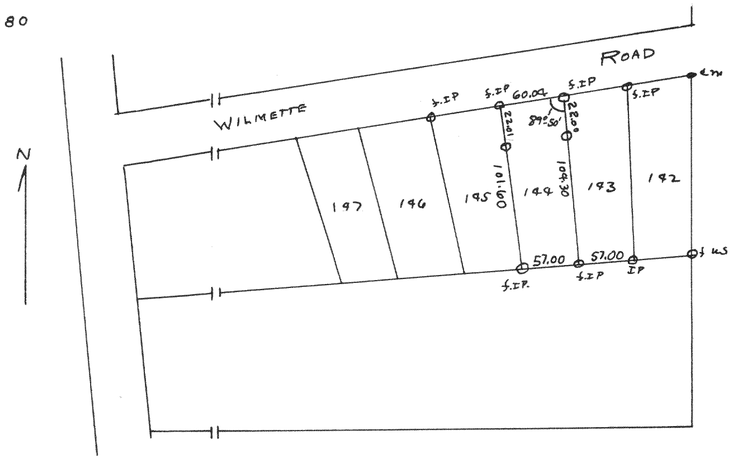

Plat of survey of lot 194 Cedar Point Park 2nd Addition
located in the Village of Williams Bay Walworth County
Aug 15, 1949

Lloyd J Jensen
County Surveyor


#2181

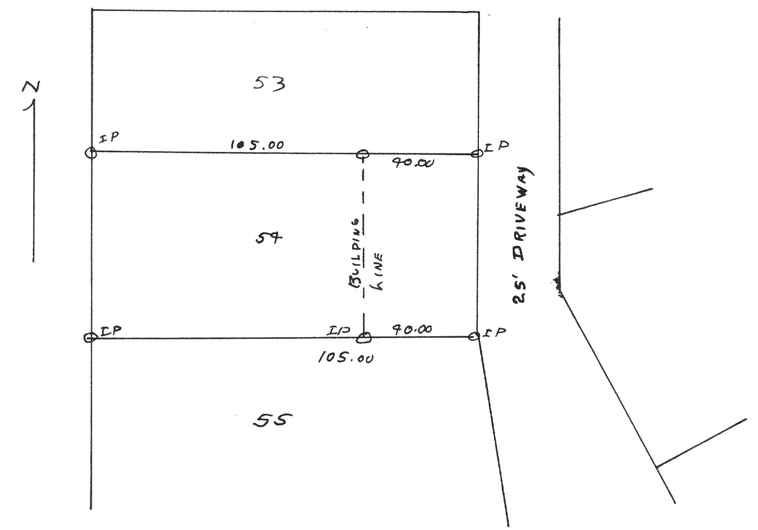

Plat of survey of lot 54 of Cedar Point Park Original Subdivision
located in the Village of Williams Bay Walworth County
April 1, 1949

Lloyd J Jensen
County Surveyor


#2182

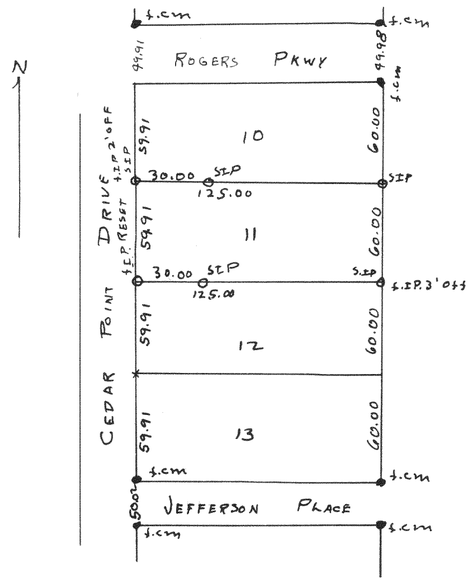

Plat of survey of lot 11 Cedar Point Park Original
located in Williams Bay Walworth County
April 29, 1949

Lloyd J Jensen
County Surveyor

#2183

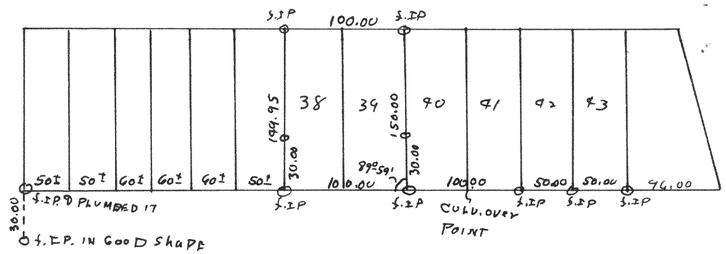

Plat of survey of lots 38 & 39 of Summer Haven Subdivision
located in the Village of Williams Bay Walworth County, Wisconsin
1949

Lloyd J Jensen
County Surveyor