

2197

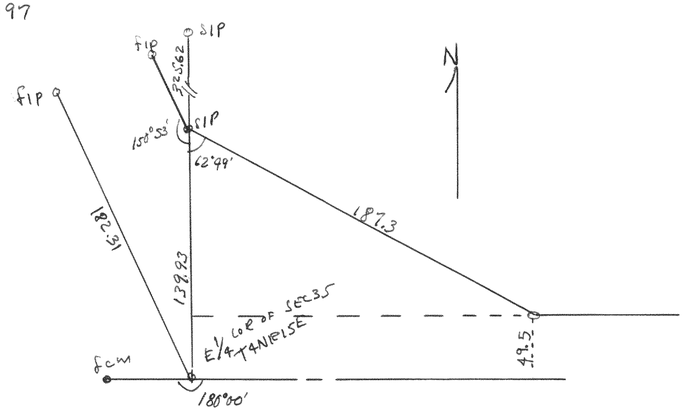

Plat of survey of land deeded to Kacheel for additional R.O.W to Kacheel farm located in Section 36, T4N R15E of Walworth County Wis.
Sept 25, 1950

Floyd L Jensen
County Surveyor


2198

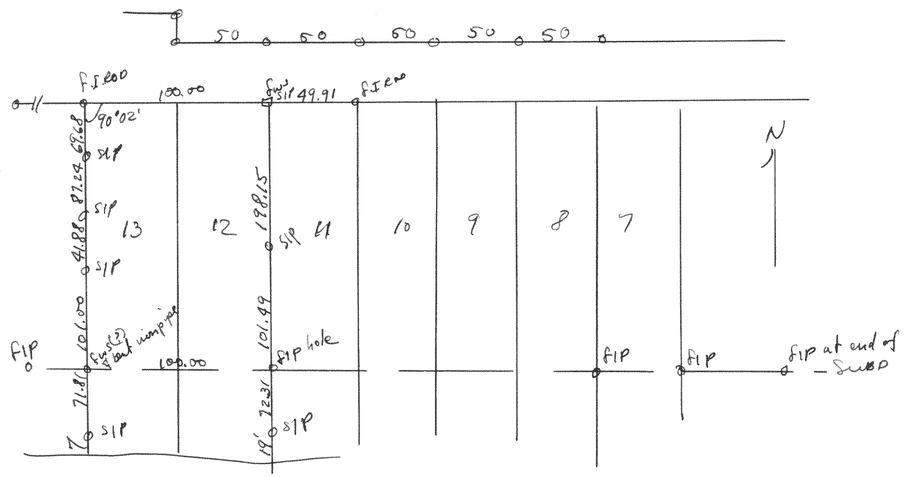

Plat of survey of lots 12 & 13 of Oak Park Subdivision located in Sec 11, T3N R15E of Walworth City Wis.
April 14, 1950

Floyd L Jensen
County Surveyor


2199

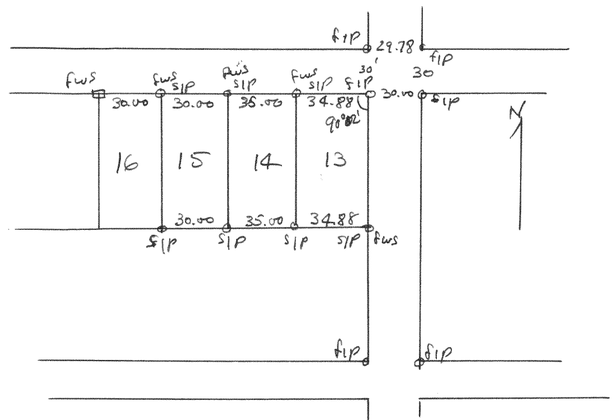

Plat of survey of lots 13, 14 & 15, Blk 11, Skansen Subd. located in Sec 9, T3N R15E of Walworth City, Wis.
June 27, 1950

Floyd L Jensen
County Surveyor

2200

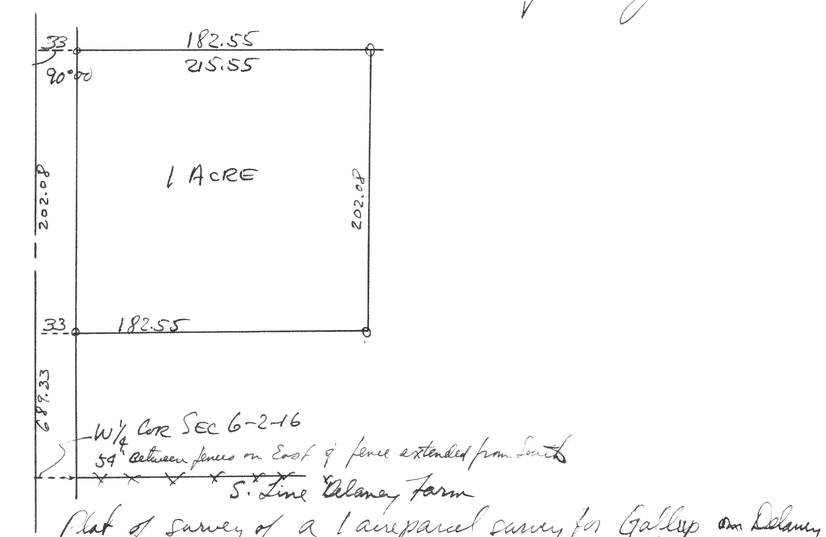

Plat of survey of a 1 acre parcel surveyed for Gallup on Delaney Farm located in the NW¼ of Sec 6, T2N R15E of Walworth County, Wis
March 28, 1950

Floyd L Jensen
County Surveyor