
492


2203

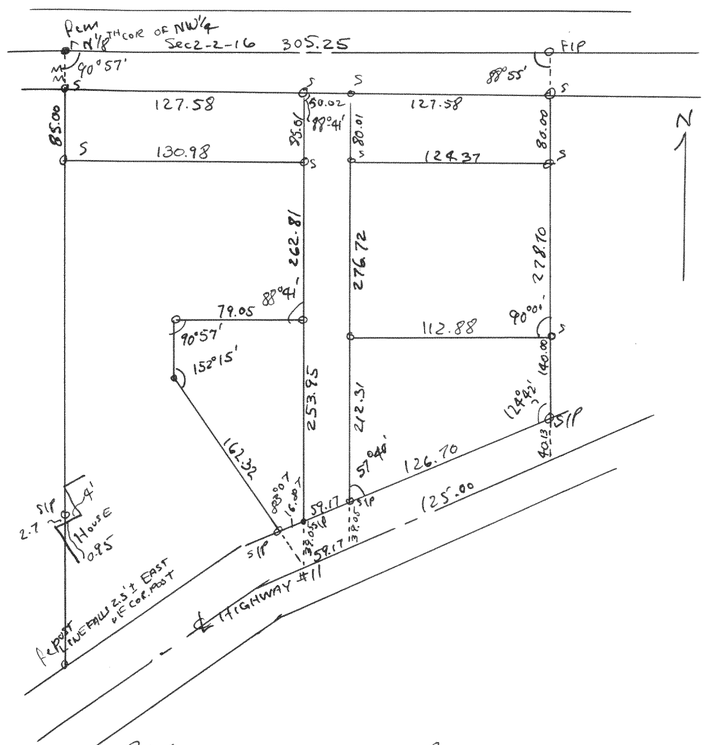

Plat of survey of parcels for Palmer's Lumber located in the NE¼ of NW¼ of Sec 2, T2NR16E of Walworth City, Wis.
April 10, 1950

Lloyd T. Jensen
County Surveyor

2204

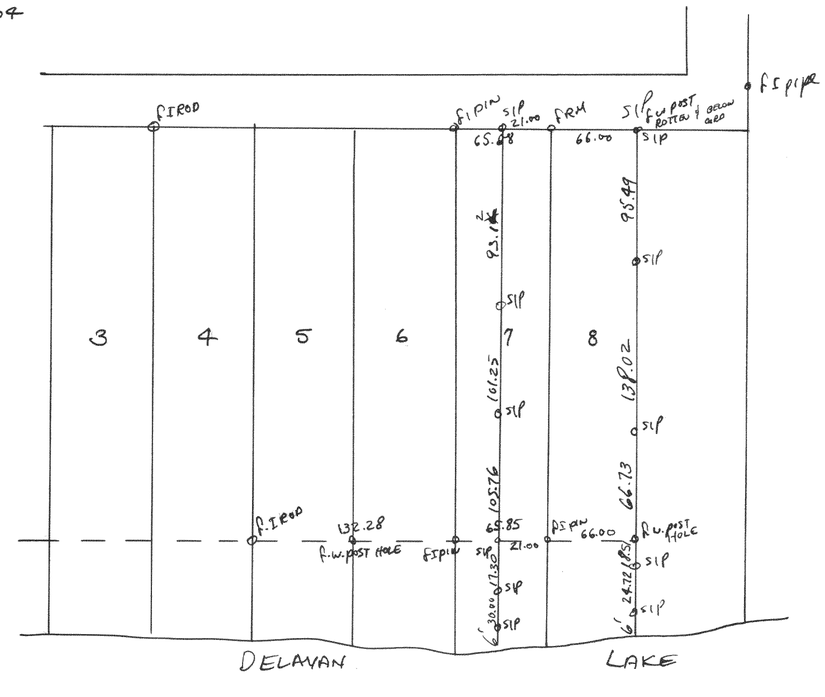

Plat of survey of Lot 8 and part of Lot 7 of Cedar Point on Delavan Lake located in Sec 28 T2NR16E of Walworth County, Wisconsin
April 18, 1950

Floyd T. Jensen
County Surveyor